IREDELL COUNTY HEALTH DEPARTMENT

This permit voids previously issued permit dated 2/19/04.

STATESVILLE 704-878-5305 cf MOORESVILLE 704-664-5281

IMPROVEMENT PERMIT / AUTHORIZATION TO CONSTRUCT / OPERATION PERMIT / EXISTING SYSTEM INSPECTION

PERMIT# 104207 PIN# 4715-08-9429 DATE 5/10/04

OWNER OR CONTRACTOR Fleetwood Homes / Mike Porter PHONE: Business (704) 876-8600 Home

ADDRESS 1270 N. Side Drive Statesville N.C. 28625

LOCATION Hwy 90 west @ Village Point Drive Lot on left side of road on corner of Village Point & Hwy 90

SUBDIVISION Village Point BLOCK / SECTION - LOT 31 LOT AREA 0.61 Acres SITE CLASS. P5 DESIGN FLOW L.T.A.R. 0.30

Septic Tank: 1,000 Gallons; STB 1012 Date 10-21-03

Pump Tank: Gallons; PT Date

Pump Make: Model Serial No.

Nitrification Field: No Fields 1 Square Feet 1200 Linear Feet 400

No Lines Five (5) Trench Width 36" Max Trench Bottom Depth 32" Gravel Depth N/A

☒ New System ☐ Repair System Type: I, II, III, IV, V, VI

System Description: Gravity, Conventional

Repair System Description: Pump, Low Pressure Pipe

Maintenance Agreement Required: ☐ Yes ☒ No

☐ House/Mod. Home ☒ Mobile Home ☐ Business ☐ Other

No. Bedrooms No. Bathrooms No. Employees

☐ Slab ☒ Crawl Space ☐ Basement w/plumbing ☐ Basement wo/plumbing


Water Supply: ☐ Individual ☒ Public ☐ Community

Comments:/Conditions: ① Maintain all setbacks


Comments:/Conditions:

- poly lok filter + ST marker Installed
- House moved w/o prior HR Approval

INITIAL SITE SKETCH Scale 1" = 40'

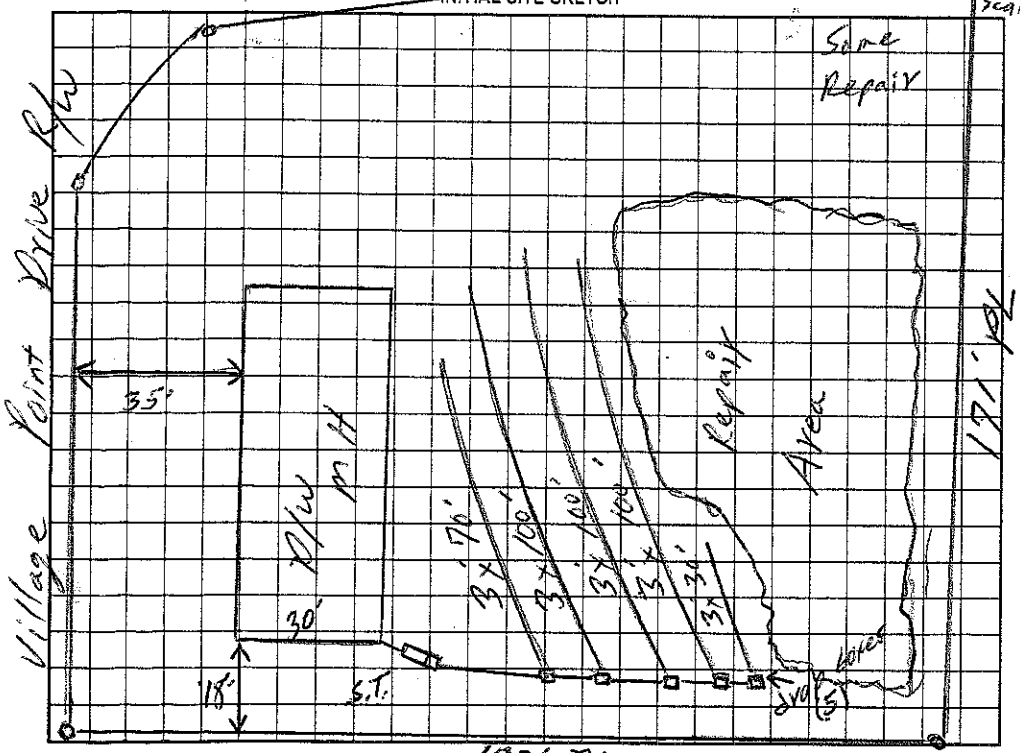

AS BUILT SKETCH 1" = 60'

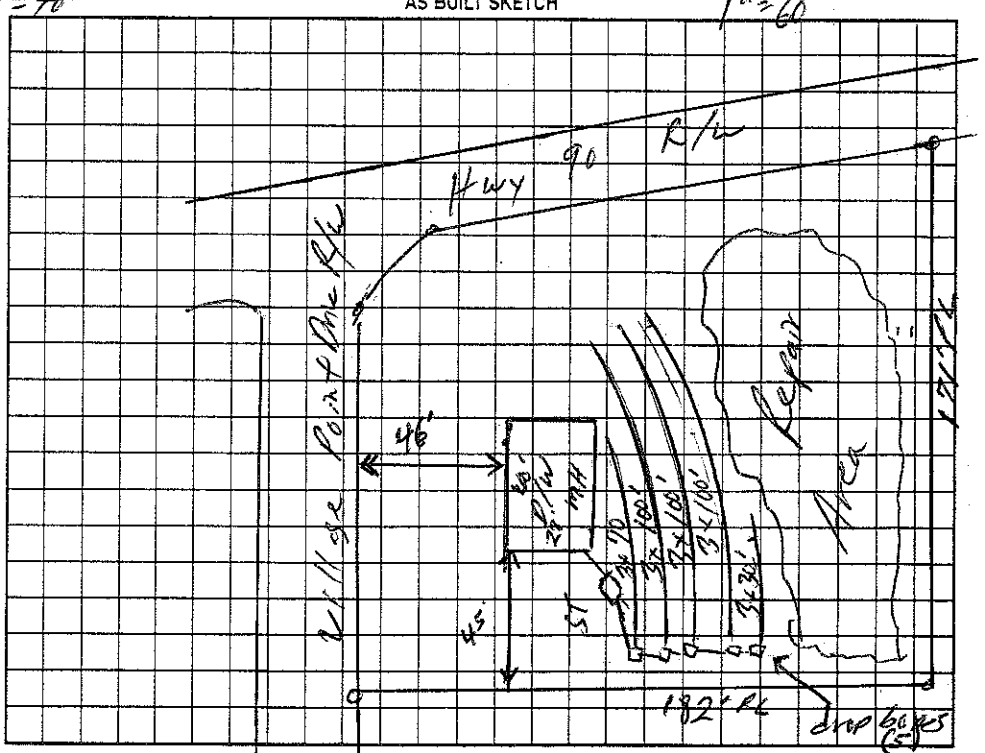

Permit can be suspended or revoked if any false information is supplied toward securing the permit/any unauthorized changes are made to the site/any unauthorized changes are made in the installation of the system. Improvement Permit with plat valid without expiration. Improvement Permit with site plan valid for sixty months. Authorization to Construct is valid for a period equal to that of Improvement Permit – not to exceed sixty months.

Signed: date 5/11/04 Installed by: Craig Thompson

Improvement Permit by: William O. Johnson date 5/10/04 Operation Permit by: William O. Johnson date 4/19/04

Authorization to Construct by: William O. Johnson date 5/10/04 Existing System Inspection by: date

HEALTH DEPT. COPY: WHITE OWNER COPY (FINAL): YELLOW OWNER COPY (INITIAL): PINK