IREDELL COUNTY HEALTH DEPARTMENT

Statesville Office (704) 878-5305 Mooresville Office (704) 660-3625 PERMIT # 205986

IMPROVEMENT PERMIT / AUTHORIZATION TO CONSTRUCT / OPERATION PERMIT / EXISTING SYSTEM

PIN # 4715176884 7886

APPLICANT: Harry Tsumas APPLICANT ADDRESS: P.O. Box 951 Statesville NC 28687

SITE ADDRESS: 124 Tarlton Rd Statesville NC PHONE: 704-252-0252 ALT. PHONE: N/A

SITE DIRECTIONS: North 64 T/R Tarlton site on Left

SUBDIVISION: N/A SECTION: N/A LOT # N/A LOT AREA: 1.873ac DESIGN FLOW: 200 gpd L.T.A.R.: 0.3

Septic Tank	Existing	(gal)	STB		Date							
Pump Tank	1000	(gal)	PT		Date							
Pump Make		Model		Serial #								
# Nitrification Fields	1	# Lines	2	Linear Ft:	200							
Trench Width	36"	Max. Trench Bottom Depth	30"	Gravel Depth	N/A							

[X] New System [ ] Repair [ ] Expansion System Type: I II [III] IV V VI

System Description: Existing

Repair System Description: 25% Reduction

Maintenance Agreement Required: [ ] YES [X] NO

[ ] GRAVITY [X] PRESSURE

[ ] Residence No. Bedrooms

[X] Business No. Persons

[ ] Other No. Employees 8

[X] Slab [ ] Crawl Space

[ ] Basement w/plumbing [ ] Basement w/o plumbing

Water Supply: [ ] Private [X] Public [ ] Community

Comments / Conditions: Install repair per site plan. Permit is to designate new repair area. No floor drains can exist within building.

INITIAL SITE SKETCH

See site plan by Jacobs On-Site Development, Inc

AS BUILT SKETCH

Permit can be suspended or revoked if any false information is supplied toward securing the permit / any unauthorized changes are made to the site / any unauthorized changes are made in the installation of the system. **CONTACT A LOCATOR SERVICE PRIOR TO ANY EXCAVATION**

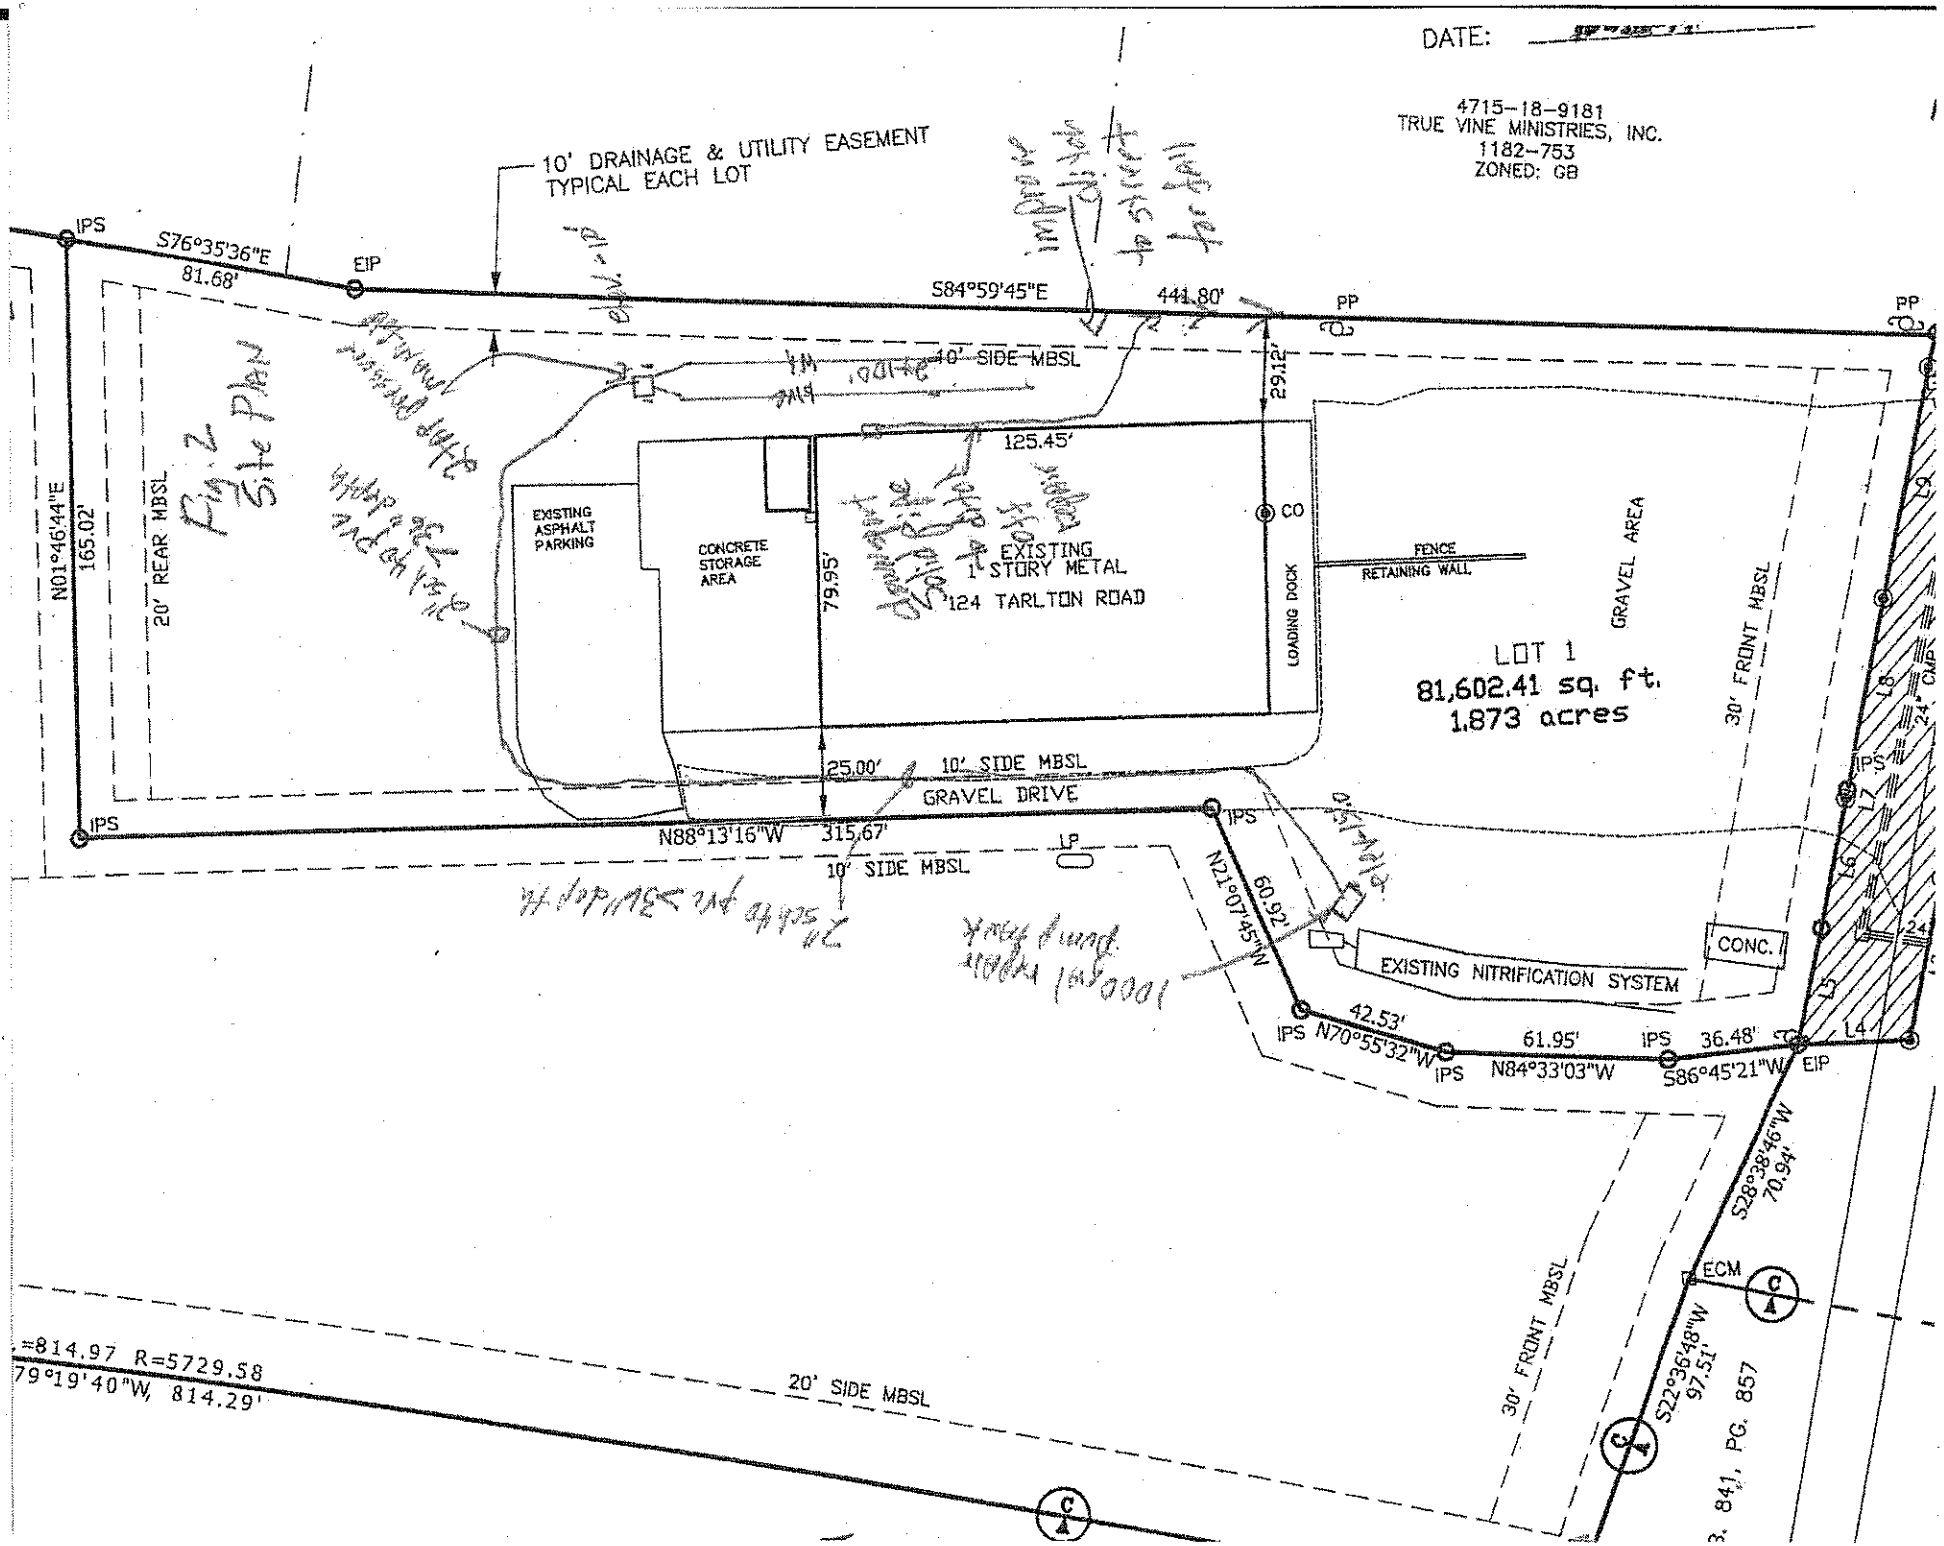
[ ] **IMPROVEMENT PERMIT** ~~*with plat*~~ *valid without expiration.* [X] **IMPROVEMENT PERMIT** *with site plan valid for 60 mos.* [X] **AUTHORIZATION TO CONSTRUCT** *valid for period equal to IMPROVEMENT PERMIT--not to exceed 60 mo.*

Owner / Applicant Signature: [signature] Date: 10/20/14 Installed by: [redacted] James Hudler

IMPROVEMENT PERMIT by: [signature] Date: 10/20/14 OPERATION PERMIT by: Steve Brown Date: 5-1-90

AUTHORIZATION TO CONSTRUCT by: [signature] Date: 10/20/14 Existing System Inspected by: Date:

Health Dept. Copy - WHITE Applicant (Final Approval) - YELLOW Applicant (Conditional Approval) - PINK


DATE:
4715-18-9181
TRUE VINE MINISTRIES, INC.
1182-753
ZONED: GB
10' DRAINAGE & UTILITY EASEMENT
TYPICAL EACH LOT
IPS
S76°35'36"E
81.68'
EIP
S84°59'45"E
441.80'
PP
PP
10' SIDE MBSL
29.12'
125.45'
N01°46'44"E
165.02'
20' REAR MBSL
EXISTING
ASPHALT
PARKING
CONCRETE
STORAGE
AREA
79.95'
EXISTING
1 STORY METAL
124 TARLTON ROAD
CO
LOADING DOCK
FENCE
RETAINING WALL
GRAVEL AREA
LOT 1
81,602.41 sq. ft.
1.873 acres
30' FRONT MBSL
25.00'
10' SIDE MBSL
GRAVEL DRIVE
IPS
N88°13'16"W
315.67'
LP
10' SIDE MBSL
N21°07'45"W
60.92'
EXISTING NITRIFICATION SYSTEM
CONC.
IPS
N70°55'32"W
42.53'
IPS
N84°33'03"W
61.95'
IPS
S86°45'21"W
36.48'
EIP
S28°38'46"W
70.94'
ECM
S22°36'48"W
97.51'
30' FRONT MBSL
=814.97 R=5729.58
79°19'40"W, 814.29'
20' SIDE MBSL
C
A
L4
L5
L6
L7
L8
L9
24" CMP