IREDELL COUNTY HEALTH DEPARTMENT

This Permit voids previously issued permit dated 10-9-00.

STATESVILLE 704-878-5305 or MOORESVILLE 704-664-5281

IMPROVEMENT PERMIT / AUTHORIZATION TO CONSTRUCT / OPERATION PERMIT / EXISTING SYSTEM INSPECTION

PERMIT# 0915594 PIN# ~~4705-98-8427 (PT)~~ 4715-18-0274 DATE 3/26/03

OWNER OR CONTRACTOR [redacted] Fleetwood Homes PHONE: Business (704) 872-0179 Home —

ADDRESS 2270 N. Side Drive Statesville N.C. 28625

LOCATION Hwy 90 West, (R) into Village Point, (R) Bridge Mill Court @ End

SUBDIVISION Village Point BLOCK / SECTION — LOT 37 LOT AREA .63 Ac. SITE CLASS P5 DESIGN FLOW 480 L.T.A.R. .3

Septic Tank: 1000 Gallons; STB 1012 Date 8-10-02
Pump Tank: — Gallons; PT — Date —
Pump Make: — Model — Serial No. —
Nitrification Field: No Fields 1 Square Feet Equi. to 1600 Linear Feet 270'
No Lines 6 @ 45 Trench Width 24" Max Trench Bottom Depth 36" Gravel Depth 6"


☒ New System ☐ Repair System Type: I, II, (III), IV, V, VI
System Description: Gravity, 50% Reduction
Repair System Description: Pump, Gravity, 50% Reduction
Maintenance Agreement Required: ☐ Yes ☒ No

☐ House/Mod. Home No. Bedrooms 4
☒ Mobile Home No. Bathrooms 2
☐ Business No. Employees —
☐ Other —
☐ Slab ☒ Crawl Space ☐ Basement w/plumbing ☐ Basement wo/plumbing

Water Supply: ☐ Individual ☒ Public ☐ Community

Comments/Conditions: (1) Do Not cut or lower house site or use of a pump may be required (2) Properly fill ditch & old road bed. (3) Stormwater must be diverted to very NW corner of lot. Exit Pipe where shown and at 20' @ 0.01 %. Existing grade (4) Install (1) Flow divider tee & two (2) distribution boxes with 62 Panels w/ 45 tons of Sand. (5) Lime & Rake Sides before filling.

INITIAL SITE SKETCH

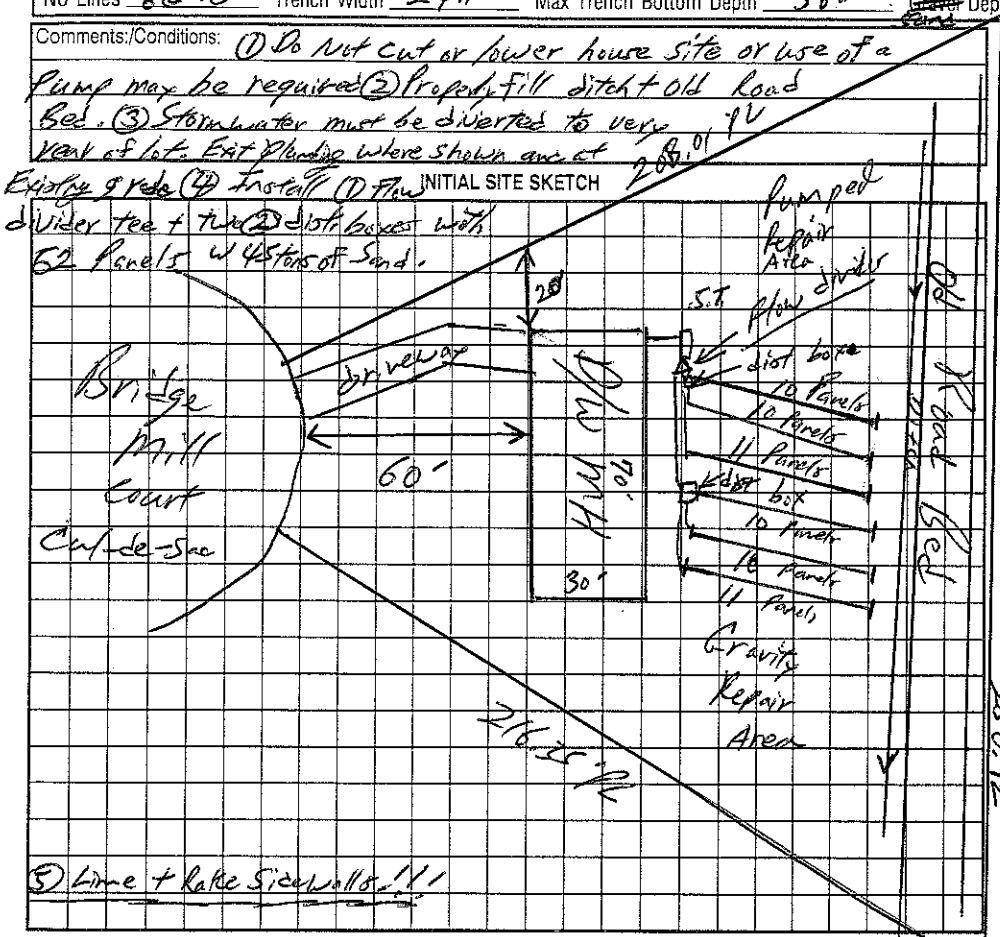

Comments/Conditions: S.T. marker & Tuff-Tite filter Installed House Not Installed on lot.

AS BUILT SKETCH

Installed as Shown Per Initial Site Sketch

Permit can be suspended or revoked if any false information is supplied toward securing the permit/any unauthorized changes are made to the site/any unauthorized changes are made in the installation of the system. Improvement Permit with plat valid without expiration. Improvement Permit with site plan valid for sixty months. Authorization to Construct is valid for a period equal to that of Improvement Permit – not to exceed sixty months.

Signed: [signature] date 3/28/03 Installed by: Craig Thompson

Improvement Permit by: William O. Johnson date 3/26/03 Operation Permit by: William O. Johnson date 4/2/03

Authorization to Construct by: William O. Johnson date 3/26/03 Existing System Inspection by: — date —

HEALTH DEPT. COPY: WHITE OWNER COPY (FINAL): YELLOW OWNER COPY (INITIAL): PINK