IREDELL COUNTY HEALTH DEPARTMENT

STATESVILLE 704-878-5305 MOORESVILLE 704-664-5281

IMPROVEMENT PERMIT / AUTHORIZATION TO CONSTRUCT / OPERATION PERMIT / EXISTING SYSTEM INSPECTION

PERMIT# 93240 PIN# 4705 98 8127 DATE 12/12/00

OWNER OR CONTRACTOR Kathy Willcox PHONE: Business _____ Home 528-7125

ADDRESS PO Box 26 Barium Springs NC 28010

LOCATION 90W, L Village Pt, L Bridge Mill Ct, cul end

SUBDIVISION Village Point BLOCK / SECTION — LOT 38 LOT AREA 0.88 AC SITE CLASS PS DESIGN FLOW 360 L.T.A.R. 0.3

Septic Tank: 1000 Gallons: STB 1012 Date 9/7/00

Pump Tank: _____ Gallons: PT _____ Date _____

Pump Make: _____ Model _____ Serial No. _____

Nitrification Field: No Fields 1 Square Feet 900 Linear Feet 300

No Lines 4 Trench Width 36" Max Trench Bottom Depth 36"

X New System ☐ Repair System Type: I, II, III, IV, V, VI

System Description: Gravity 25% Reduc.

Repair System Description: Pump 25% Reduc.

Maintenance Agreement Required: ☐ Yes X No

Gravel Depth _____

X House/Mod. Home No. Bedrooms 3

☐ Mobile Home No. Bathrooms 2

☐ Business No. Employees _____

☐ Other _____


☐ Slab X Crawl Space ☐ Basement w/plumbing ☐ Basement wo/plumbing

Water Supply: ☐ Individual X Public ☐ Community


Comments/Conditions:

Comments/Conditions: Poly Lok filter + Infiltrators Installed

INITIAL SITE SKETCH

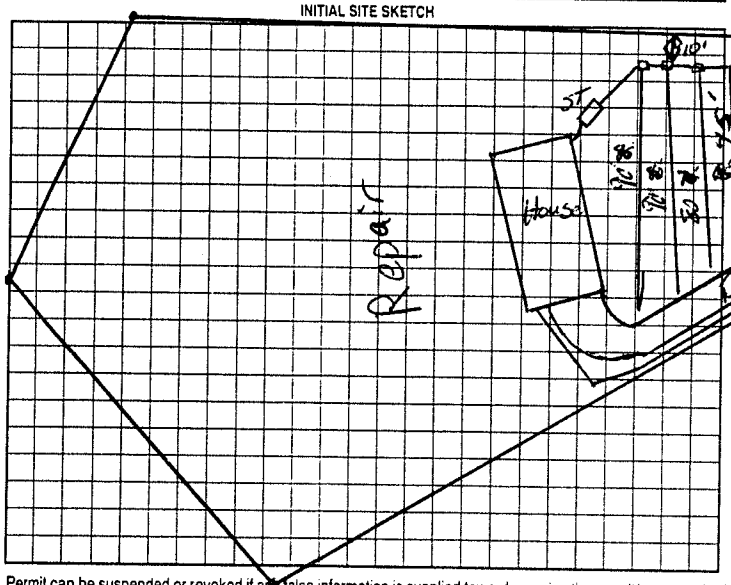

AS BUILT SKETCH

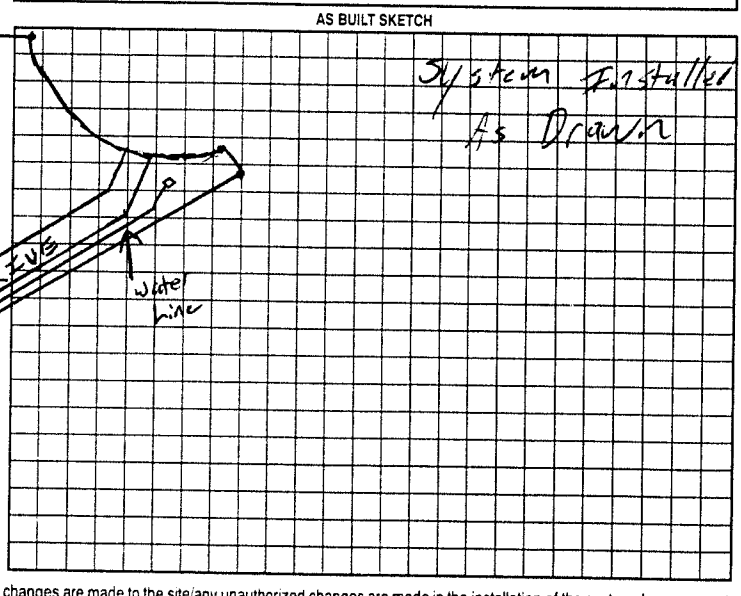

Permit can be suspended or revoked if any false information is supplied toward securing the permit/any unauthorized changes are made to the site/any unauthorized changes are made in the installation of the system. Improvement Permit with plat valid without expiration. Improvement Permit with site plan valid for sixty months. Authorization to Construct is valid for a period equal to that of Improvement Permit – not to exceed sixty months.

Signed: Renee M. Rice date 12/13/00 Installed by: A-1 Backhoe

Improvement Permit by: RSI date 12/14/00 Operation Permit by: RSI date 12/15/00

Authorization to Construct by: RSI date 12/12/00 Existing System Inspection by: _____ date _____

HEALTH DEPT. COPY: WHITE OWNER COPY (FINAL): YELLOW OWNER COPY (INITIAL): PINK