IREDELL COUNTY HEALTH DEPARTMENT

Statesville Phone TR 3-7271 Mooresville Phone No. 664-5281

PERMIT TO INSTALL SEPTIC TANK

Permit No. _____ Permit Date 5-18 19-73

Owner Purtle Holesclaw Address Statesville N.C.

Installed By Henry Norman Address Statesville N.C.


Location of Property Hwy # 90 - Above Loray about 1 Mile on R. Big Brick house back off of road.

Tank		Capacity		Length of Lines		Fixtures	
Block	( )	1000	(✓)	225'	(✓)	No. of Baths	(1)
Precast	(✓)	1250	( )	250'	( )	Dishwasher	( )
		1500	( )	Other _____		Garbage Grdr.	( )
		Other _____				Other _____	

NOTIFY HEALTH DEPARTMENT AT LEAST EIGHT HOURS BEFORE TANK IS TO BE INSPECTED.

Final Inspection 5-18 1973 Approved (✓) Disapproved ( )

Remarks Well 55' from system

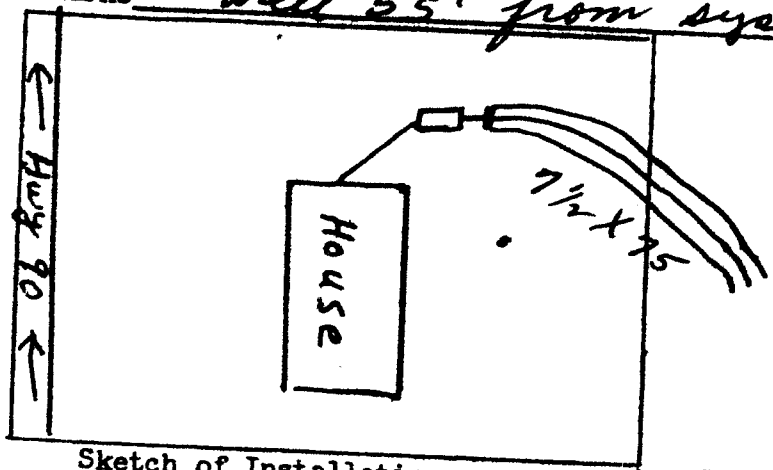

Sketch of Installation

E. G. Stevenson

Sanitarian