IREDELL COUNTY HEALTH DEPARTMENT

Statesville Phone TR 3-7271 Mooresville Phone NO 3-1271

PERMIT TO INSTALL SEPTIC TANK

Permit No. _____ Permit Date 7-21 1972

Owner Carlton-Rinaldo Address Statesville N.C.

Installed By Same Address Taylorsville N.C.


Location of Property Out Hwy 90 - T.L. into Carol-Lynn Acres above Loray - Go to end of Stuart Bear to Right House on left. Lot # 18

Tank		Capacity		Length of Lines		Fixtures	
Block	( )	1000	(✓)	225'	( )	No. of Baths	(1½)
Precast	(✓)	1250	( )	250'	( )	Dishwasher	( )
		1500	( )	Other 344'		Garbage Grdr.	( )
		Other 800		902 sq ft.		Other	

NOTIFY HEALTH DEPARTMENT AT LEAST EIGHT HOURS BEFORE TANK IS TO BE INSPECTED.

Final Inspection 7-21 1972 Approved (✓) Disapproved ( )

Remarks Alexander Water Corp

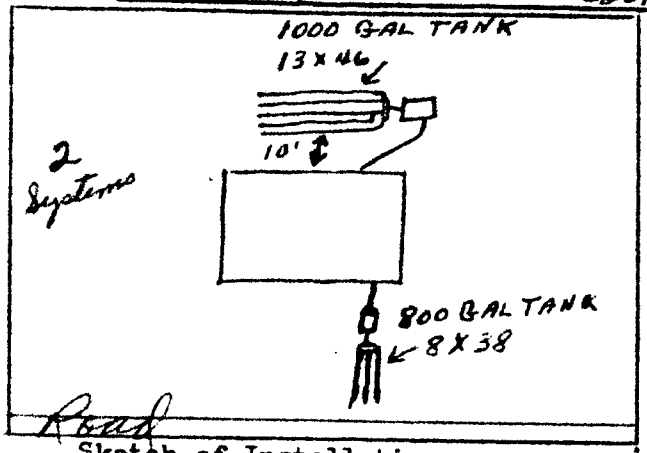

Sketch of Installation

Nitrification lines of system at rear of house not the required 15' away from basement. Builder must accept full responsibility if sewage backs into basement at any future time.

E. A. Stevenson

Sanitarian