This permit voids previously issued permit dated 4/14/04.

IREDELL COUNTY HEALTH DEPARTMENT

STATESVILLE 704-878-5305 MOORESVILLE 704-664-5281

IMPROVEMENT PERMIT / AUTHORIZATION TO CONSTRUCT / OPERATION PERMIT / EXISTING SYSTEM INSPECTION

PERMIT# Repair PIN# 4715-25-3202 DATE 4-22-2004

OWNER OR CONTRACTOR William S. Gelber PHONE: Business – Home (704) 873-1625

ADDRESS 190 St. Jill Circle Statesville, N.C. 28625

LOCATION Hwy 64 E, (L) Tarlton Rd (R) on St. Jill Circle at ½ way point of circle

SUBDIVISION Carol-Lynn ACRES BLOCK / SECTION _____ LOT 37 LOT AREA 1.0 Acre SITE CLASS. _____ DESIGN FLOW 360 L.T.A.R. Ex

Septic Tank: 1000 Gallons; STB 379 Date 3-22-04

Pump Tank: _____ Gallons; PT _____ Date _____

Pump Make: _____ Model _____ Serial No. _____

Nitrification Field: No Fields 1 Square Feet 585 Linear Feet 130

No Lines 1 Trench Width 36" Max Trench Bottom Depth – Gravel Depth 30"

☐ New System ☒ Repair System Type: I (II) III, IV, V, VI

System Description: –

Repair System Description: Gravity Conventional

Maintenance Agreement Required: ☑ Yes ☒ No

☒ House/Mod. Home No. Bedrooms 3

☐ Mobile Home No. Bathrooms 2

☐ Business No. Employees _____

☐ Other _____


☐ Slab ☐ Crawl Space ☒ Basement w/plumbing ☐ Basement wo/plumbing

Water Supply: ☐ Individual ☒ Public ☐ Community


Comments:/Conditions: (1) Pump out Septic Tank (2) Crush & Fill Old Tank (3) Install New Septic Tank / Reinforced (≥ 36" deep) w/S.T. risers (2) to top of ground (4) Add 130 ft of line w 18" of gravel (Re: Tarlton - Linville 5-31-94)

Comments:/Conditions: Center of Septic Tank 14' From back of House. - Spread reinforced S.T. Installed. - Installed 110 Ft of gravel w/30" of stone - Septic Tank Risers Installed, Old Septic lines disconnected from System.

INITIAL SITE SKETCH

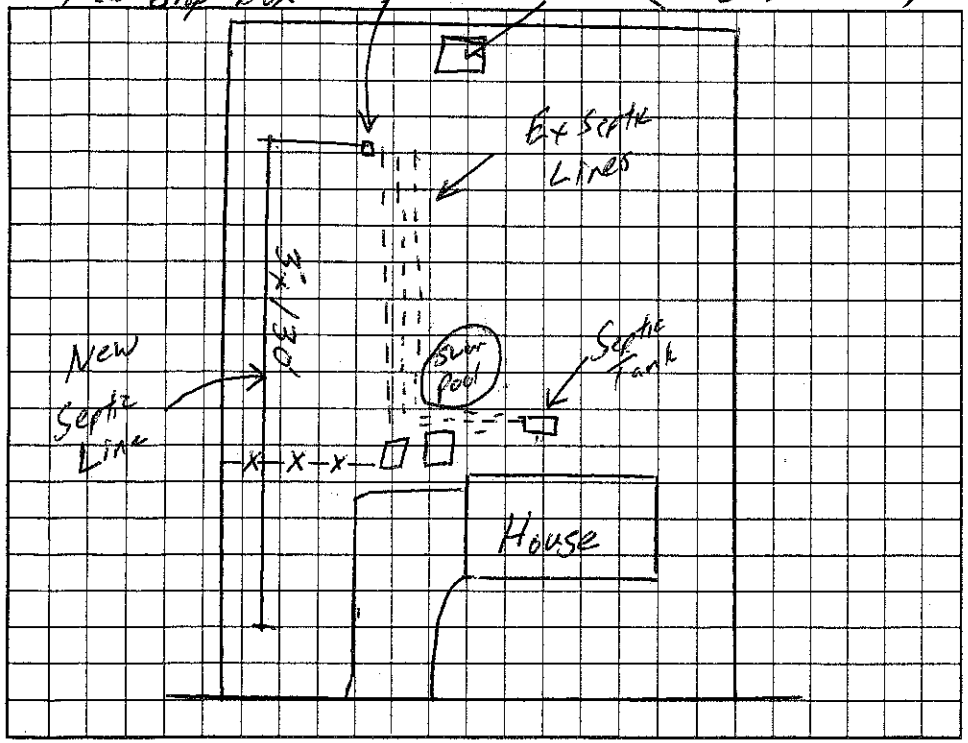

AS BUILT SKETCH

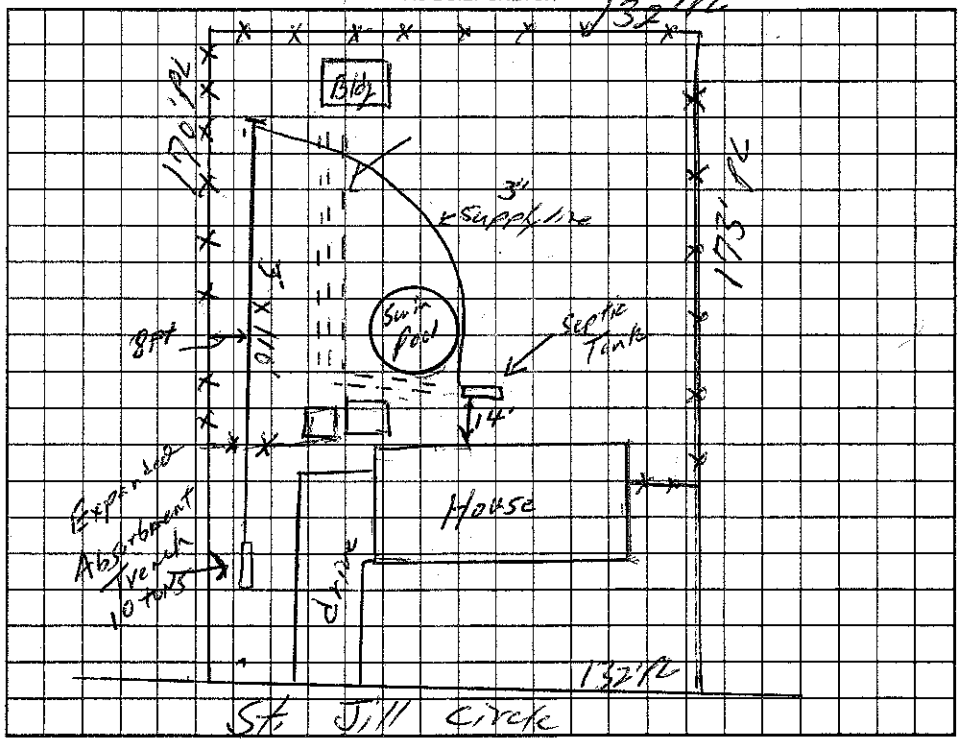

Permit can be suspended or revoked if any false information is supplied toward securing the permit/any unauthorized changes are made to the site/any unauthorized changes are made in the installation of the system. Improvement Permit with plat valid without expiration. Improvement Permit with site plan valid for sixty months. Authorization to Construct is valid for a period equal to that of Improvement Permit – not to exceed sixty months.

Signed: _____ date 4-22-04 Installed by: James Hudler

Improvement Permit by: _____ date 4/22/04 Operation Permit by: _____ date 5/7/04

Authorization to Construct by: _____ date 4/22/04 Existing System Inspection by: _____ date _____

HEALTH DEPT. COPY: WHITE OWNER COPY (FINAL): YELLOW OWNER COPY (INITIAL): PINK