IREDELL COUNTY HEALTH DEPARTMENT

Statesville Phone TR 3-7271 Mooresville Phone No. 664-5281

PERMIT TO INSTALL SEPTIC TANK

Permit No. 671 Permit Date 8-24 1973

Owner Carlton-Rinaldo Bldg. Address Statesville N.C.

Installed By Jaylorsville Grading Co. Address Jaylorsville N.C.


Location of Property Hwy #90 above Loray. Turn into Carol-Lynn Acres. Go 1st at Circle. House on R. Lot # 33

Tank		Capacity		Length of Lines		Fixtures	
Block	( )	1000	(✓)	225'	( )	No. of Baths	(1½)
Precast	(✓)	1250	( )	250'	( )	Dishwasher	(–)
		1500	( )	Other 300 900 sq ft		Garbage Grdr.	(–)
		Other				Other	

NOTIFY HEALTH DEPARTMENT AT LEAST EIGHT HOURS BEFORE TANK IS TO BE INSPECTED.

Final Inspection 8-24 1973 Approved (✓) Disapproved ( )

Remarks Alexander Water Corp.

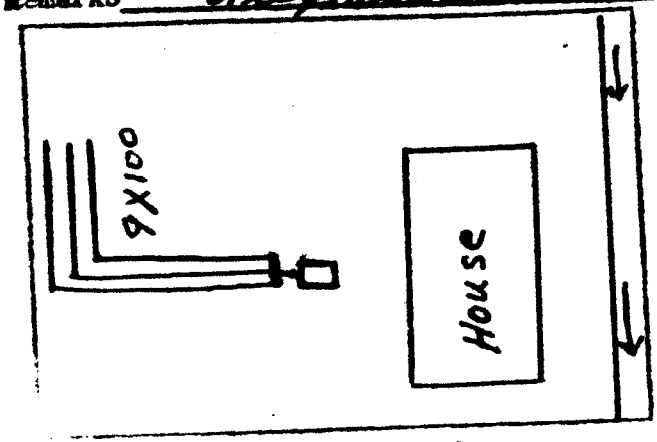

Sketch of Installation

E. A. Stevenson
Sanitarian