IREDELL COUNTY HEALTH DEPARTMENT

STATESVILLE 704-878-5305 MOORESVILLE 704-664-5281

IMPROVEMENT PERMIT / CERTIFICATE OF COMPLETION / OPERATION PERMIT / EXISTING SYSTEM INSPECTION

PROPERTY DESCRIPTION NO. Repair DATE 4-24-97 TAX MAP NO. Repair

OWNER OR CONTRACTOR Terry Hensley PHONE: Business Home 872-5549

ADDRESS 154 St. Jill Circle Statesville Watershed: ☐ Yes ☐ No

LOCATION 64 W TL Tarlton Rd TL St Jill Circle #154

SUBDIVISION BLOCK / SECTION LOT LOT AREA SITE CLASS. DESIGN FLOW 360 L.T.A.R. 0.3

Septic Tank: 1000 Gallons: STB Date

Pump Tank: Existing Gallons: PT Date

Pump Make: Model Serial No

Nitrification Field: No Fields 2 Square Feet Linear Feet 180

No Lines 4 Trench Width 36in Max Trench Bottom Depth 36in Gravel Depth Sand

☐ New System ☒ Repair System Type: I, II, III IV, V, VI

System Description:

Repair System Description: Gravity Chambers

Maintenance Agreement Required: ☐ Yes ☐ No

☒ House/Mod. Home No. Bedrooms 3

☐ Mobile Home No Bathrooms 1½

☐ Business No. Employees

☐ Other


☐ Slab ☐ Crawl Space ☐ Basement w/plumbing ☐ Basement wo/plumbing

Water Supply: ☐ Individual ☐ Community ☒ Public


Comments: Keep lines on contour, 9ft on center 1 line 5 chambers (30ft) 3 lines 8 Chambers (50ft) Pump Tank Check Sanitary T replace if needed Remove Tree & Check house for leaks

Comments:

INITIAL SITE SKETCH

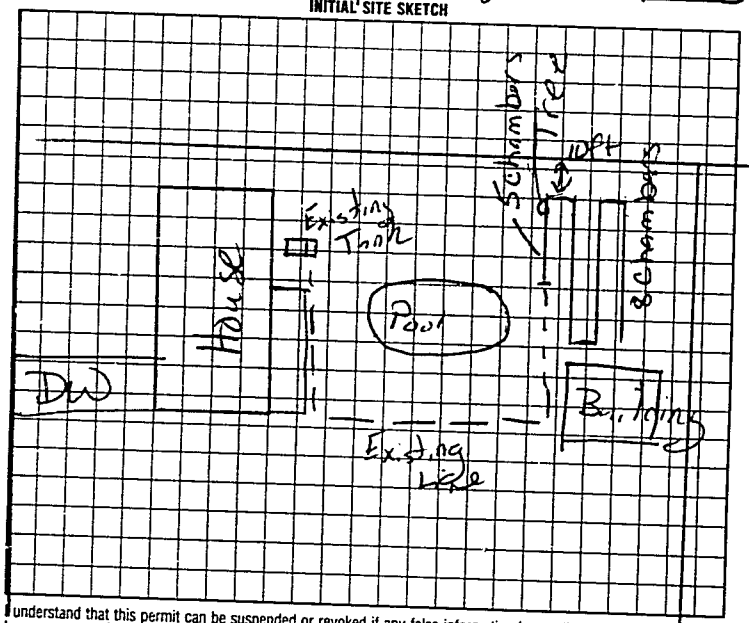

AS BUILT SKETCH

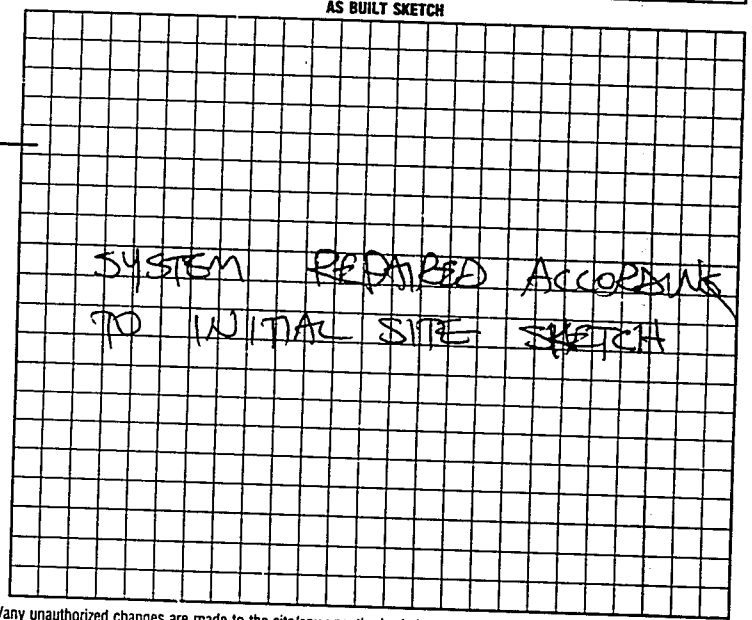

I understand that this permit can be suspended or revoked if any false information is supplied toward securing the permit/any unauthorized changes are made to the site/any unauthorized changes are made in the installation of the system. Improvement Permit is valid for 60 months from date of issuance.

Signed: Sherry Hensley

Improvement Permit by: Mark C. Oakes RS date 4-24-97

System Inspection by: Authorization Expired. Mark C. Oakes RS date 4-24-97

Installed by: A-1 BACKHOE

Certificate of Completion by: date

Operation Permit by: STEVE HENRICK date 6-20-97

HEALTH DEPT. COPY: WHITE INSPECTION COPY (FINAL): GREEN OWNER COPY (FINAL): YELLOW INSPECTION COPY (INITIAL): PINK OWNER COPY (INITIAL) GOLD