IREDELL COUNTY HEALTH DEPARTMENT

Statesville Phone TR 3-7271 Mooresville Phone NO 3-1271

PERMIT TO INSTALL SEPTIC TANK

Permit No. 522 Permit Date 6-27 1973

Owner Jarlton - Rinaldo Land Co Address Taylorsville NC

Installed By Taylorsville Grading Co. Address Taylorsville N.C.


Location of Property Hwy 90 W. Past Loray - Turn into Carol-Lynn Acres. House on R. Lot # 32

Tank		Capacity		Length of Lines		Fixtures	
Block	( )	1000	(✓)	225'	( )	No. of Baths	(1½)
Precast	(✓)	1250	( )	250'	( )	Dishwasher	(-)
		1500	( )	Other 345		Garbage Grdr.	(-)
		Other		920 sq ft		Other	

NOTIFY HEALTH DEPARTMENT AT LEAST EIGHT HOURS BEFORE TANK IS TO BE INSPECTED.

Final Inspection 6-27 1973 Approved (✓) Disapproved ( )

Remarks Alexander Watr Corp.

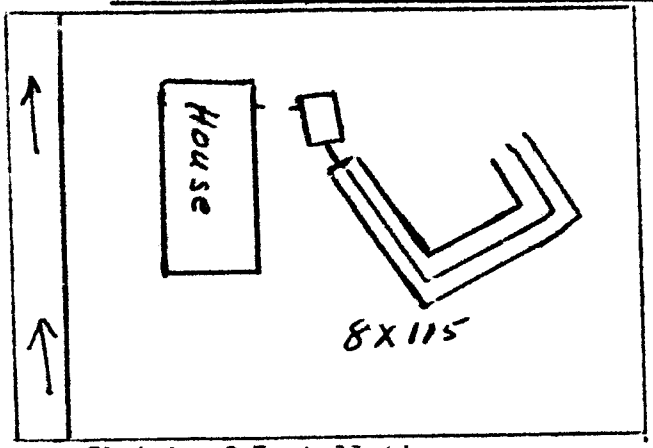

Sketch of Installation

E. A. Stevenson

Sanitarian