IREDELL COUNTY HEALTH DEPARTMENT

STATESVILLE 704-878-5305 MOORESVILLE 704-664-5281

IMPROVEMENT PERMIT / CERTIFICATE OF COMPLETION / OPERATION PERMIT / EXISTING SYSTEM INSPECTION

PROPERTY DESCRIPTION NO. Repair DATE 9-1-93 TAX MAP NO. Repair

OWNER OR CONTRACTOR Frank Combs PHONE: Business Home 873-9761

ADDRESS Rt. 8. Box 446, Statesville, N.C. 28677

LOCATION Hwy 90 W TL Tarlton Rd. TL St. Jill Circle, 6th house on R.

SUBDIVISION Carolynn Acres. BLOCK / SECTION LOT LOT AREA SITE CLASS. P.S. L.T.A.R. Repair

Water Supply: ☐ Individual ☐ Community ☑ Public county water

Septic Tank: Existing Gallons: STB Date

Pump Tank: Gallons: PT Date

Nitrification Field: No Fields 2 Square Feet 600 Linear Feet 200'

No Lines 5 Trench Width 36" Trench Depth 18"-36" Gravel Depth 12"

☐ New System ☑ Repair System Type: I, II, III, IV, V, VI

System Description: Conventional, gravity

Repair System Description: " "

Maintenance Agreement Required: ☐ Yes ☑ No

☑ House/Mod. Home ☐ Mobile Home ☐ Business ☐ Other


No. Bedrooms 3 No. Bathrooms 1.5 No. Employees —

Garbage Disposal: ☐ Yes ☑ No Auto. Dishwasher: ☐ Yes ☑ No Auto. Washing Machine: ☑ Yes ☐ No Other

☐ Slab ☑ Crawl Space ☐ Basement w/plumbing ☐ Basement wo/plumbing

Comments INSTALL SYSTEM AS SHALLOW AS POSSIBLE (no deeper than 36" to bottom of trench) Keep Nitrification lines on contour. Keep system min. 10' from all property lines, 6' from existing system, and 5' from any building foundation. Install Bull-Run valve between systems. Check integrity of existing tank, install new sanitary tee if needed.

INITIAL SITE SKETCH

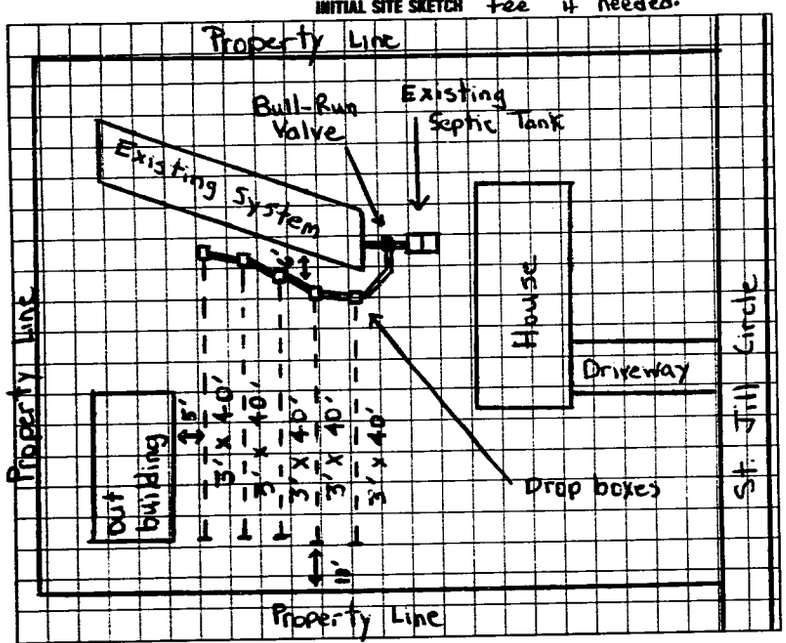

AS BUILT SKETCH

1- Jet rodded out old drain lines (they were clogged up)

2- installed bull-run-valve between initial system and repair lines

#1 on Bull-run-valve to repair lines

#2 on Bull-run-valve to existing system

3- only able to install 185' of repair lines. 555 sq. ft.

4- Installation same as initial sketch

I understand that this permit can be suspended or revoked if any false information is supplied toward securing the permit/any unauthorized changes are made to the site/any unauthorized changes are made in the installation of the system. Improvement Permit is valid for 60 months from date of issuance.

Signed: Brenda G. Combs

Improvement Permit by: Michael J. Dennis date 9-1-93

Existing System Inspection by: date

Installed by: AAA Enterprises

Certificate of Completion by: Michael J. Dennis date 9-15-93

Operation Permit by: date

HEALTH DEPT. COPY: WHITE INSPECTION COPY (FINAL): GREEN OWNER COPY (FINAL): YELLOW INSPECTION COPY (INITIAL): PINK OWNER COPY (INITIAL): GOLD