IREDELL COUNTY HEALTH DEPARTMENT

Statesville Phone TR 3-7271 Mooresville Phone No. 664-5281

PERMIT TO INSTALL SEPTIC TANK

Permit No. [illegible] Permit Date 5-1 1973

Owner Carlton-Rinaldo Address Statesville N.C.

Installed By Taylorsville Grading Co Address Taylorsville, N.C.

Location of Property

Carol-Lynn Acres


Lot # 29 House on R.

Tank		Capacity		Length of Lines		Fixtures	
Block	( )	1000	(✓)	225'	( )	No. of Baths	(1½)
Precast	(✓)	1250	( )	250'	( )	Dishwasher	( )
		1500	( )	Other 300 900 sq ft		Garbage Grdr.	( )
		Other				Other	

NOTIFY HEALTH DEPARTMENT AT LEAST EIGHT HOURS BEFORE TANK IS TO BE INSPECTED.

Final Inspection 5-1 1973 Approved (✓) Disapproved ( )

Remarks C.o Alexander Water Corp.

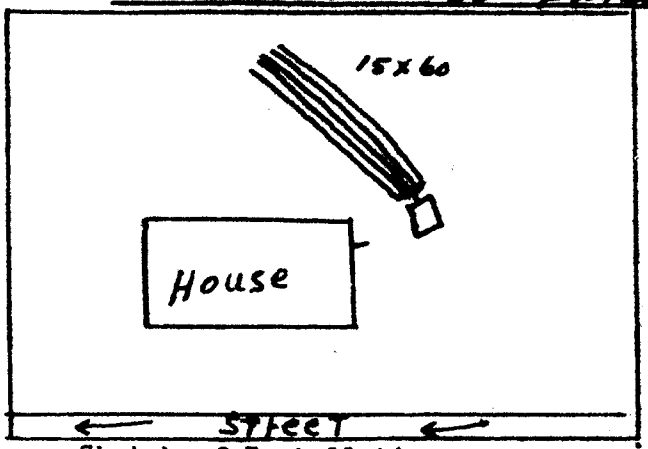

Sketch of Installation

E. G. Stevenson

Sanitarian