IREDELL COUNTY HEALTH DEPARTMENT

STATESVILLE 704-878-5305 MOORESVILLE 704-664-5281

IMPROVEMENT PERMIT / AUTHORIZATION TO CONSTRUCT / OPERATION PERMIT / EXISTING SYSTEM INSPECTION

PERMIT# 14838 PIN# 4715256299 DATE 12-4-07

OWNER OR APPLICANT Gus Workman PHONE: Business Home

ADDRESS 19600 W. Catawba Ave Suite A-102 Cornelius 28031

LOCATION 64W to Exit 30 to Statesville Rd to Jetton Rd to Lee Lot on left

SUBDIVISION BLOCK / SECTION LOT 1 LOT AREA .564 SITE CLASS. PS DESIGN FLOW 360 L.T.A.R. .25

Septic Tank: 1000 Gallons; STB 794 Date 3-16-07

Pump Tank: Gallons; PT Date

Pump Make: Model Serial No.

Nitrification Field: No Fields Square Feet 1440 Linear Feet 360

No Lines 3 Trench Width 36" Max Trench Bottom Depth 30" Gravel Depth N/A

☑ New System ☐ Repair ☐ Expansion System Type: I II III IV V VI

System Description: 25% Graywater

Repair System Description: 50% Low Pressure

Maintenance Agreement Required: ☐ Yes ☐ No

☑ House/Mod. Home ☐ Mobile Home ☐ Business ☐ Other

No. Bedrooms 3 No. Persons No. Employees

Water Supply: ☐ Individual ☑ Public ☐ Community

☐ Gravity ☐ Pressure ☐ Slab ☑ Crawl Space ☐ Basement w/plumbing ☐ Basement wo/plumbing


Comments/Conditions:

Red Polylock
Septic tank marker

Comments/Conditions:

Install on Contour
Maintain all setbacks

INITIAL SITE SKETCH

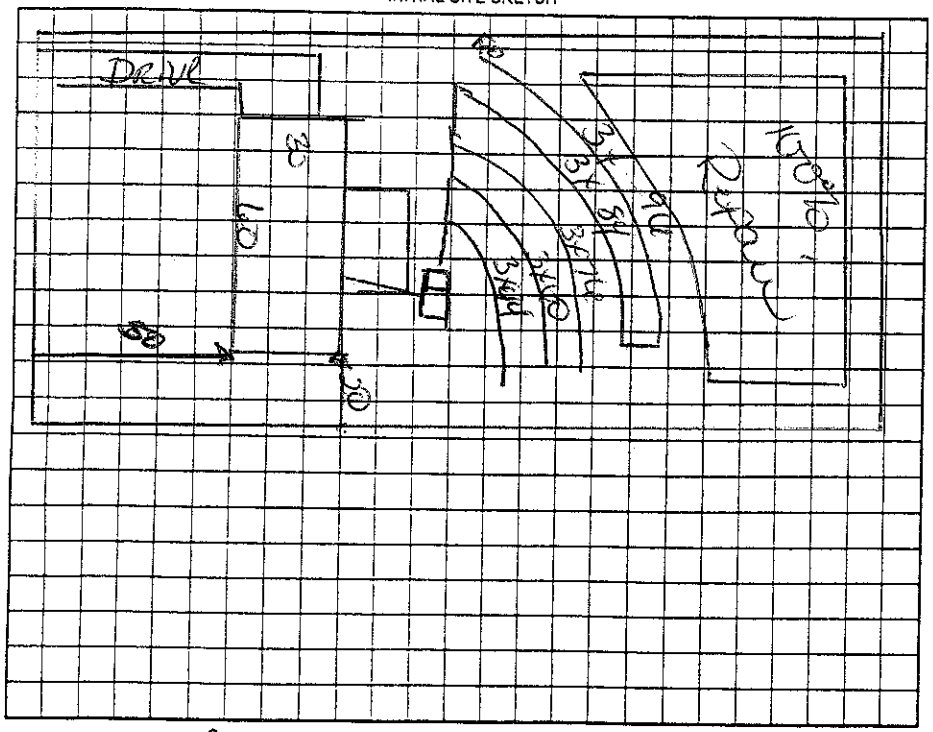

AS BUILT SKETCH

Ended distribution

Permit can be suspended or revoked if any false information is supplied toward securing the permit/any unauthorized changes are made to the site/any unauthorized changes are made in the installation of the system. Improvement Permit with plat valid without expiration ☐ Improvement Permit with site plan valid for sixty months ☐ Authorization to Construct is valid for a period equal to that of Improvement Permit – not to exceed sixty months.

Signed: Dennis Gadlin date

Improvement Permit by: Kelly Cook date 12-4-07

Authorization to Construct by: Kelly Cook date 12-4-07

Installed by: A-Z Backhoe

Operation Permit by: Kelly Cook date 12-5-07

Existing System Inspection by: date

HEALTH DEPT. COPY: WHITE OWNER COPY (FINAL): YELLOW OWNER COPY (INITIAL): PINK