IREDELL COUNTY HEALTH DEPARTMENT

Statesville Office (704) 878-5305 Mooresville Office (704) 660-3625

IMPROVEMENT PERMIT / AUTHORIZATION TO CONSTRUCT / OPERATION PERMIT / EXISTING SYSTEM

PERMIT # 208092

PIN # 4715257200

APPLICANT: Angela B Campbell APPLICANT ADDRESS: 187 Loray Ln

SITE ADDRESS: 177 St Jill Cir Statesville NC 28625 PHONE: 704-872-5243 ALT. PHONE: N/A

SITE DIRECTIONS: Weston hwy 64 T/L Tarlton Rd T/L St Jill Cir Lot on left

SUBDIVISION: Ellis Watt + Angela B Campbell SECTION: N/A LOT # 2 LOT AREA: 0.575 ac DESIGN FLOW: 360 L.T.A.R.: 0.275

Septic Tank	1000	(gal)	STB	168	Date	7-16-15	☒ New System	☐ Repair	☐ Expansion	System Type: I II ☒ III IV V VI	
Pump Tank	N/A	(gal)	PT	N/A	Date	N/A	System Description:	25% Reduction			
Pump Make	N/A	Model	PolyFlo		Serial #	PL-68	Repair System Description:	25% Reduction			
# Nitrification Fields	1	# Lines	4		Linear Ft:	332'	Maintenance Agreement Required:	☐ YES	☒ NO		
Trench Width	36"	Max. Trench Bottom Depth	36"		Gravel Depth	N/A	☒ GRAVITY	☐ PRESSURE			

☒ Residence ☐ Business ☐ Other ☐ Slab ☐ Basement w/plumbing


No. Bedrooms 3 No. Persons 6 No. Employees ☒ Crawl Space

☐ Basement w/o plumbing


Water Supply: ☐ Private ☒ Public ☐ Community

Comments / Conditions: Install 25% Reduction on contour with Serial distribution

INITIAL SITE SKETCH

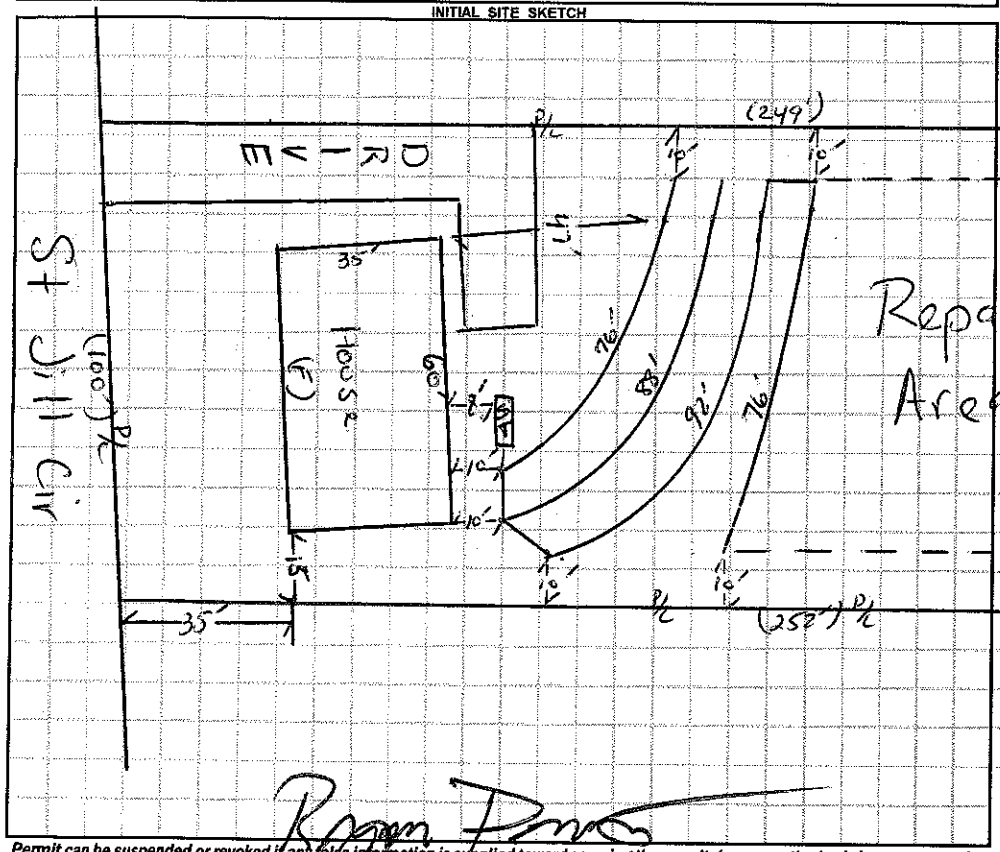

AS BUILT SKETCH

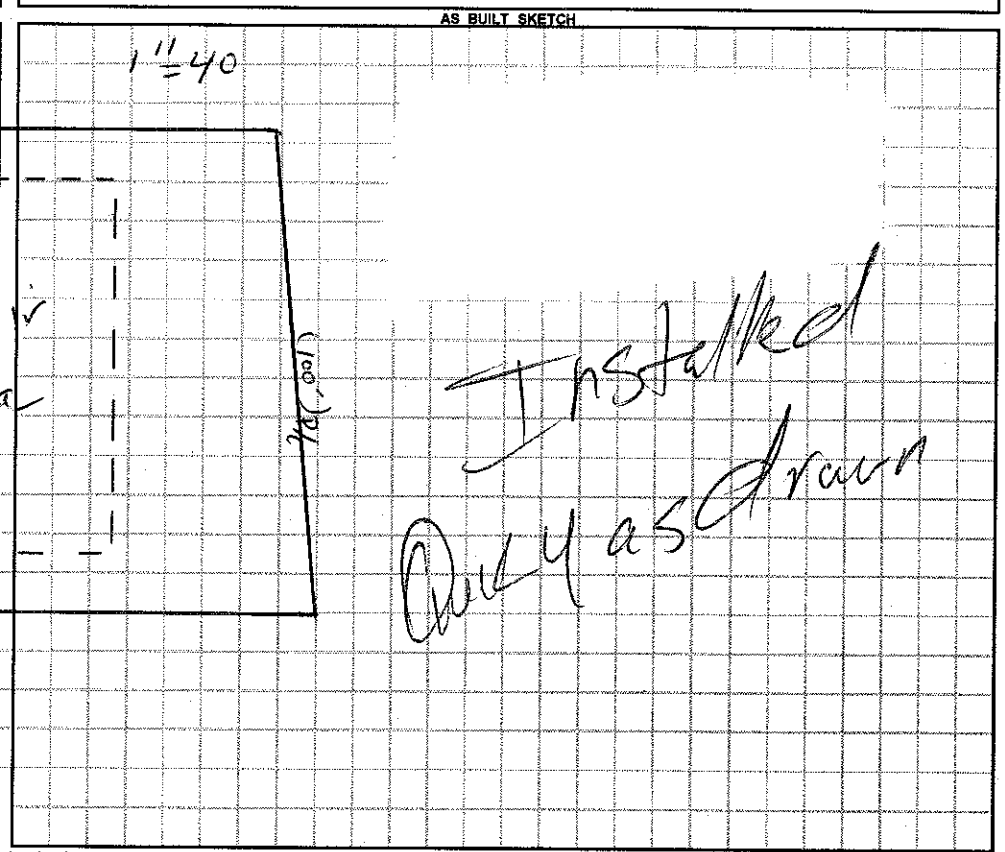

Ryan Barnes

Permit can be suspended or revoked if any false information is supplied toward securing the permit / any unauthorized changes are made to the site / any unauthorized changes are made in the installation of the system. **CONTACT A LOCATOR SERVICE PRIOR TO ANY EXCAVATION**

☐ **IMPROVEMENT PERMIT** *with plat valid without expiration.* ☒ **IMPROVEMENT PERMIT** *with site plan valid for 60 mos.* ☐ **AUTHORIZATION TO CONSTRUCT** *valid for period equal to IMPROVEMENT PERMIT--not to exceed 60 mo.*

Owner / Applicant Signature: Angela B Campbell Date: 2/10/15 Installed by: Barnes Grading

IMPROVEMENT PERMIT by: Debbie Higgins Date: 02/10/15 OPERATION PERMIT by: Date: 09/10/15

AUTHORIZATION TO CONSTRUCT by: Debbie Higgins Date: 05/06/15 Existing System Inspected by: Date:

Health Dept. Copy - WHITE Applicant (Final Approval) - YELLOW Applicant (Conditional Approval) - PINK