IREDELL COUNTY HEALTH DEPARTMENT

Statesville Phone TR 3-7271 Mooresville Phone NO 3-1271

PERMIT TO INSTALL SEPTIC TANK

Permit No. 158 Permit Date _____ 19__

Owner Tarheel Rinaldo Address Taylorsville

Installed By Dent Jim Lackey Address Stony Point


Location of Property Carol-Lynn Acres off #90 N. Alexander Water Proposed. Lot #20.

Tank		Capacity		Length of Lines		Fixtures	
Block	( )	1000	( )	225'	( )	No. of Baths	(2)
Precast	(✓)	1250	( )	250'	( )	Dishwasher	( )
		1500	( )	Other 900 sq. '		Garbage Grdr.	( )
		Other _____				Other _____	

NOTIFY HEALTH DEPARTMENT AT LEAST EIGHT HOURS BEFORE TANK IS TO BE INSPECTED.

Final Inspection 9-8- 1971 Approved (✓) Disapproved ( )

Remarks _____

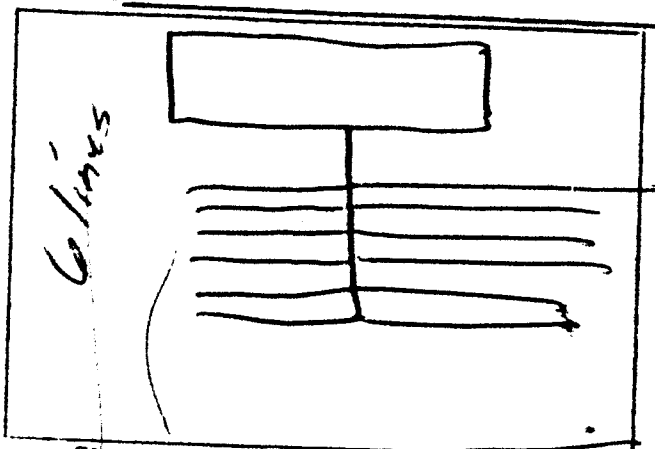

Sketch of Installation

Cecil S. Hall

Sanitarian