IREDELL COUNTY HEALTH DEPARTMENT

Statesville Phone TR 3-7271 Mooresville Phone NO 3-1271

PERMIT TO INSTALL SEPTIC TANK

Permit No. 158 Permit Date _____ 19__

Owner Tarlton & Rinaldo Land Co Address Taylorsville

Installed By Don & Jim Lackey Address Stony Point


Location of Property Carol-Lynn Development off Hgwy #90N. Lot #21 Community water proposed from Alexander Water Corp

Tank		Capacity		Length of Lines		Fixtures	
Block	( )	1000	(✓)	225'	( )	No. of Baths	(2)
Precast	(✓)	1250	( )	250'	( )	Dishwasher	( )
		1500	( )	Other 900 sq.	✓	Garbage Grdr.	( )
		Other _____				Other _____	

NOTIFY HEALTH DEPARTMENT AT LEAST EIGHT HOURS BEFORE TANK IS TO BE INSPECTED.

Final Inspection 9-8-1971 Approved (✓) Disapproved ( )

Remarks _____

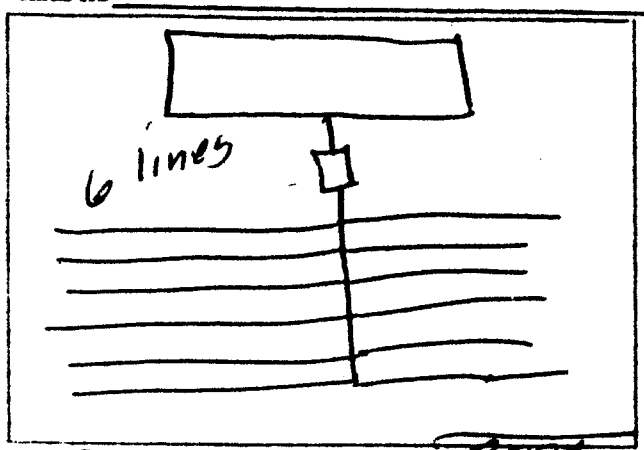

Sketch of Installation Front

Carson S. Hall

Sanitarian