IREDELL COUNTY HEALTH DEPARTMENT

STATESVILLE 704-878-5305 MOORESVILLE 704-664-5281

IMPROVEMENT PERMIT / AUTHORIZATION TO CONSTRUCT / OPERATION PERMIT / EXISTING SYSTEM INSPECTION

PERMIT# Repair PIN# 4715-26-0455 DATE 6/29/04

OWNER OR CONTRACTOR A. Keith + Jane Wilson PHONE: Business — Home (704) 871-9069

ADDRESS 224 St Jill Circle Statesville N.C. 28625

LOCATION Hwy 64 West, (L) Tarlton, @ Intersection site is straight across RE corner of ST Jill Circle

SUBDIVISION Carol Lynn BLOCK / SECTION — LOT 23 LOT AREA 200 x 100 SITE CLASS. RS DESIGN FLOW 480 L.T.A.R. Ex.

Septic Tank: Existing Gallons: STB Date

Pump Tank: Gallons: PT Date

Pump Make: Model Serial No.

Nitrification Field: No Fields 1 Square Feet Linear Feet 150

No Lines 2 @ 75' Trench Width 36" Max Trench Bottom Depth — Gravel Depth 18"

☐ New System ☒ Repair System Type: I (II) III, IV, V, VI

System Description: Grav.

Repair System Description: Gravity, Conventional

Maintenance Agreement Required: ☐ Yes ☒ No

☒ House/Mod. Home No. Bedrooms 4

☐ Mobile Home No. Bathrooms 3

☐ Business No. Employees


☐ Other

☐ Slab ☐ Crawl Space ☒ Basement w/plumbing ☐ Basement wo/plumbing

Water Supply: ☐ Individual ☒ Public ☐ Community

Comments:/Conditions: ① Pump out Septic Tank (Replace Tank if needed) (2) Check dist. box (replace if needed) (3) Add two (2) 25ft lines with 18" of gravel with three (3) drop boxes. (4) This permit serves as N.O.V. - 30 days to repair system.


INITIAL SITE SKETCH

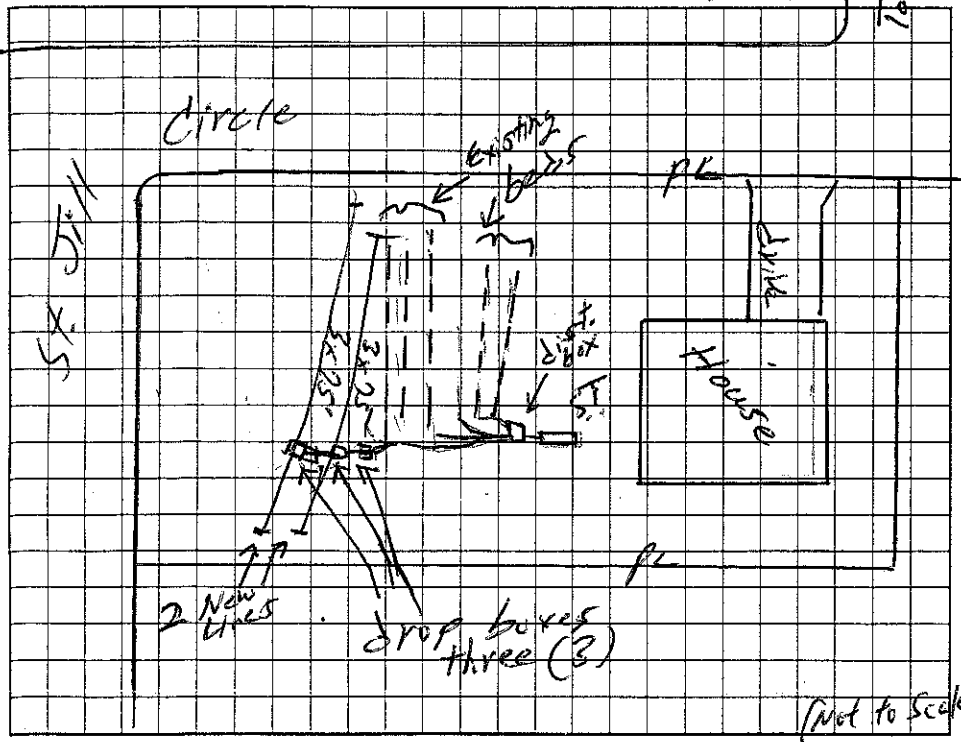

Comments:/Conditions:

- Installed New Septic Tee in Tank
- Installed 150ft of Septic Line

AS BUILT SKETCH

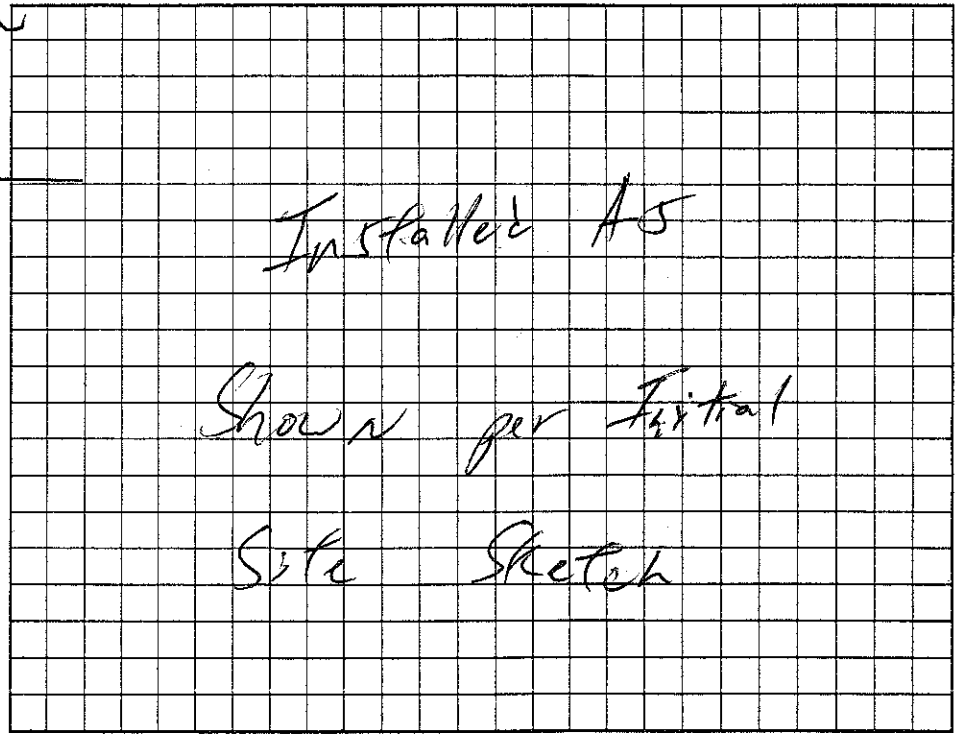

Permit can be suspended or revoked if any false information is supplied toward securing the permit/any unauthorized changes are made to the site/any unauthorized changes are made in the installation of the system. Improvement Permit with plat valid without expiration. Improvement Permit with site plan valid for sixty months. Authorization to Construct is valid for a period equal to that of Improvement Permit – not to exceed sixty months.

Signed: Jane Wilson date 6-29-04 Installed by: Brent Galliher

Improvement Permit by: William O. Johnson date 6/29/04 Operation Permit by: William O. Johnson date 7/23/04

Authorization to Construct by: William O. Johnson date 6/29/04 Existing System Inspection by: date

HEALTH DEPT. COPY: WHITE OWNER COPY (FINAL): YELLOW OWNER COPY (INITIAL): PINK