IREDELL COUNTY HEALTH DEPARTMENT

Statesville Phone TR 3-7271 — Mooresville Phone NO 3-1271

PERMIT TO INSTALL SEPTIC TANK

Permit No. 175 — Permit Date 7-21 1972

Owner Carlton - Rinaldi — Address Statesville N.C.

Installed By Same — Address Taylorsville N.C.


Location of Property Out Hwy 90 - T.L. into Carl-Lynn acres above Loray - Go to end of Strut Bear to R. House on L. Lot # 19

Tank		Capacity		Length of Lines		Fixtures	
Block	( )	1000	(✓)	225'	( )	No. of Baths	(1½)
Precast	(✓)	1250	( )	250'	( )	Dishwasher	( )
		1500	( )	Other 300'		Garbage Grdr.	( )
		Other		900 sq ft		Other	

NOTIFY HEALTH DEPARTMENT AT LEAST EIGHT HOURS BEFORE TANK IS TO BE INSPECTED.

Final Inspection 7-21 1972 — Approved (✓) Disapproved ( )

Remarks Alexander Water Corp.

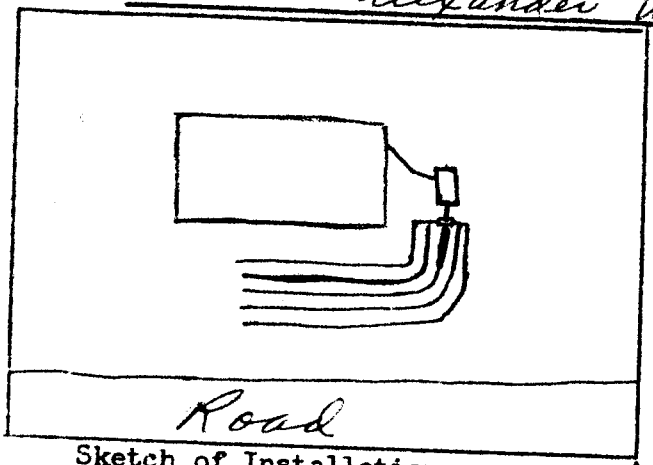

Sketch of Installation

E. G. Stevenson

Sanitarian