IREDELL COUNTY HEALTH DEPARTMENT - *ENVIRONMENTAL HEALTH* ☐ STATESVILLE OFFICE 704-878-5305 ☐ MOORESVILLE OFFICE 704-664-5281

IMPROVEMENT PERMIT / AUTHORIZATION TO CONSTRUCT / OPERATION PERMIT / EXISTING SYSTEM INSPECTION

PERMIT # REPAIR PIN # 4715-26-1996 DATE MAY 15, 2012

OWNER MICHAEL S. MCDONALD APPLICANT PHONE: Home/Cell # 704-872-2724 Business # 704-878-4431 (O) 881-4543 (C)

SITE ADDRESS 167 TARLTON ROAD OWNER / APPLICANT ADDRESS SAME STATESVILLE NC 28625

SITE DIRECTIONS US 64 WEST TL TARLTON ROAD 2ND HOUSE ON LEFT AT # 167

SUBDIVISION CAROL LYNN Ac BLOCK / SECTION ~~A~~ 2 LOT # 49 LOT AREA 0.714 Ac DESIGN FLOW 480 L.T.A.R. EXIST

Septic Tank 1000 Gallons: STB 794 Date 4-21-12 ☐ New System ☑ Repair ☐ Expansion System Type I (II) III IV V VI

Pump Tank ____ Gallons: P T ____ Date ____ System Description: ____

Pump Make ____ Model ____ Serial # ____ Repair System Description: CONVENTIONAL SEPTIC TANK

No. Nitrification Fields: 1 No. Lines EX Linear Feet EX Maintenance Agreement Required ☐ YES ☑ NO

Trench Width EX Max. Trench Bottom Depth EX Gravel Depth EX ☑ GRAVITY ☐ PRESSURE

☑ Residence No. Bedrooms 4 ☐ Business No. Persons ____ ☐ Other No. Employees ____ ☐ Slab ☐ Crawl Space ☑ Basement w/plumbing ☐ Basement w/o plumbing


Water Supply ☐ Private ☑ Public ☐ Community

Comments / Conditions INSTALL NEW 1000 GALLON SEPTIC TANK AT LOCATION SHOWN, MINIMUM 5' FROM DECK FOUNDATION POST.

SEPTIC TANK WITH RISERS INSTALLED USING "RED" THETTE FILTER

INITIAL SITE SKETCH

~SCALE: 1"= 40'

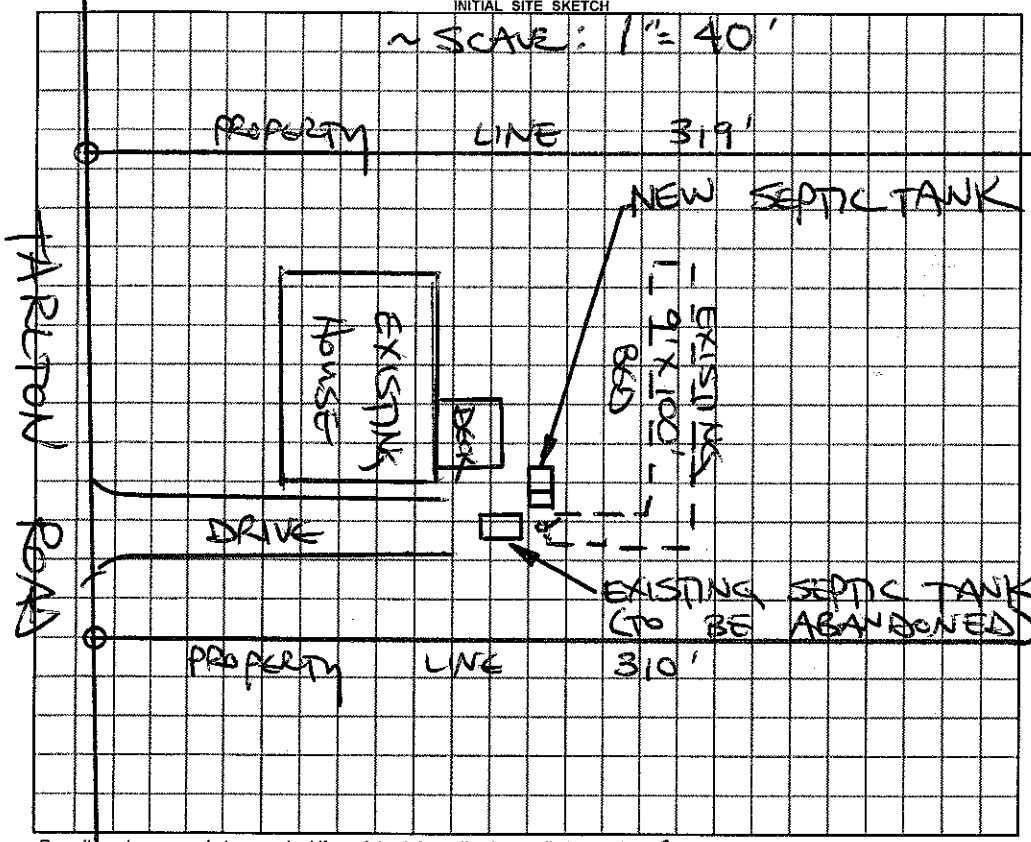

AS BUILT SKETCH

SEPTIC TANK INSTALLED ACCORDING TO INITIAL SITE SKETCH

Permit can be suspended or revoked if any false information is supplied toward securing the permit / any unauthorized changes are made to the site / any unauthorized changes are made in the installation of the system.

☐ ***IMPROVEMENT PERMIT*** *with plat valid without expiration.* ☑ ***IMPROVEMENT PERMIT*** *with plat valid without expiration.* site plan valid 60 mo. ☑ ***AUTHORIZATION TO CONSTRUCT*** valid for period equal to IMPROVEMENT PERMIT--not to exceed 60 mo.

Owner / Applicant Signature: [signature] Date 5/16/12 Installed by: JAMES HADLER

IMPROVEMENT PERMIT by: STEVE HEDRICK REHS Date 5/15/2012 OPERATION PERMIT by: STEVE HEDRICK REHS Date 6-4-12

AUTHORIZATION TO CONSTRUCT by: STEVE HEDRICK REHS Date 5/15/2012 Existing System Inspected by: ____ REHS Date ____

YOU SHOULD CONTACT A LOCATOR SERVICE PRIOR TO ANY EXCAVATION

White Copy – Environmental Health YELLOW COPY (Final) Owner / Applicant PINK COPY (Initial) Owner / Applicant