900

IREDELL COUNTY HEALTH DEPARTMENT

Statesville Phone TR 3-7271 Mooresville Phone NO 3-1271

PERMIT TO INSTALL SEPTIC TANK

Permit No. 129 Permit Date 6-15 1972

Owner Tarlton & Rinaldo Address Taylorsville N.C.

Installed By Self Address


Location of Property out Hwy 90 above Wilkinson Grs beyond Loray Tk. into Coral Lynn Acres go to end of st T.L. then T.R. 1st House on R Lot # 25

Tank		Capacity		Length of Lines		Fixtures	
Block	( )	1000	(✓)	225'	( )	No. of Baths	(1½)
Precast	(✓)	1250	( )	250'	( )	Dishwasher	( )
		1500	( )	Other 900 sq ft		Garbage Grdr.	( )
		Other				Other	

NOTIFY HEALTH DEPARTMENT AT LEAST EIGHT HOURS BEFORE TANK IS TO BE INSPECTED.

Final Inspection 6-15 1972 Approved (✓) Disapproved ( )

Remarks Alexander Water Corp

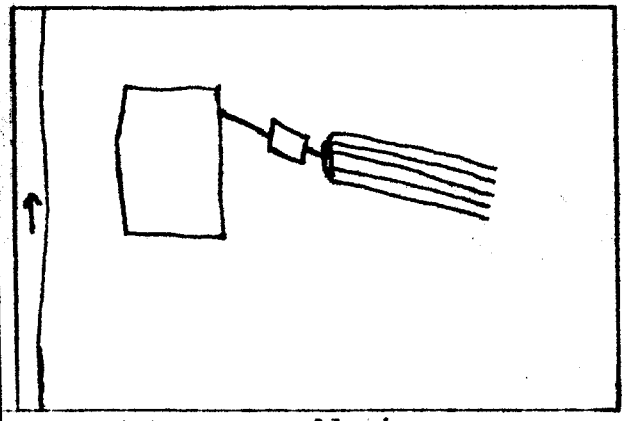

Sketch of Installation

Mr K. W. Johnson assisted in this inspection.

E. A. Stevenson

Sanitarian