IREDELL COUNTY HEALTH DEPARTMENT

Statesville Phone TR 3-7271 Mooresville Phone NO 3-1271

PERMIT TO INSTALL SEPTIC TANK

Permit No. 127 Permit Date 6-14 1972

Owner Carlton & Rinaldo Address Taylorsville NC

Installed By Self Address


Location of Property Out #90 Past Wilkinsons Gro above Loray T.L. into Carol-Lynn Acres. Go to end of Strut T.L. 1st house on R. Lot # 24

Tank		Capacity		Length of Lines		Fixtures	
Block	( )	1000	(✓)	225'	( )	No. of Baths	(1/2)
Precast	(✓)	1250	( )	250'	( )	Dishwasher	( )
		1500	( )	Other 900 ft		Garbage Grdr.	( )
		Other				Other	

NOTIFY HEALTH DEPARTMENT AT LEAST EIGHT HOURS BEFORE TANK IS TO BE INSPECTED.

Final Inspection 6-14- 1972 Approved (✓) Disapproved ( )

Remarks Alexander Water Corp.

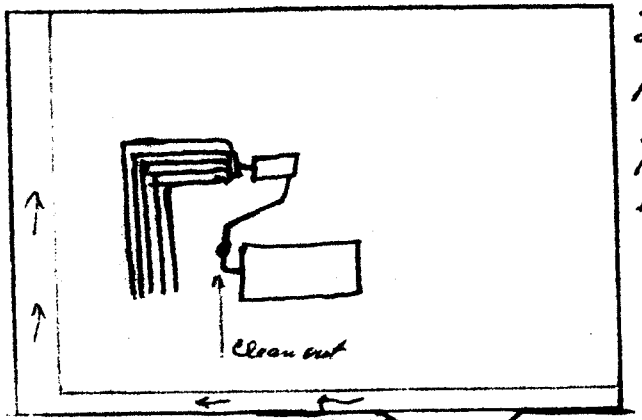

Sketch of Installation

Lines from house to tank has too many turns. Could give trouble. Clean out plug installed.

E. G. Stevenson

Sanitarian