IREDELL COUNTY HEALTH DEPARTMENT

Statesville Phone TR 3-7271 Mooresville Phone NO 3-1271

PERMIT TO INSTALL SEPTIC TANK

Permit No. 6958 Permit Date 8-15 1972

Owner Jarlton + Rinaldo Address Statesville NC

Installed By Same Address

Location of Property Out Hwy #90 above Loray

T.L. into Carl Lynn Acres.


Lot # 28

Tank		Capacity		Length of Lines		Fixtures	
Block	( )	1000	(✓)	225'	( )	No. of Baths	(1½)
Precast	(✓)	1250	( )	250'	( )	Dishwasher	( )
		1500	( )	Other 336 912 sq ft		Garbage Grdr.	( )
		Other				Other	

NOTIFY HEALTH DEPARTMENT AT LEAST EIGHT HOURS BEFORE TANK IS TO BE INSPECTED.

Final Inspection 8-15 1972 Approved (✓) Disapproved ( )

Remarks Alexander Water Corp

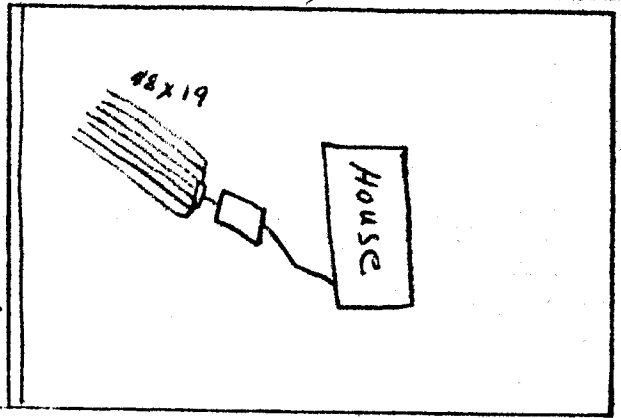

Sketch of Installation

Better layout could have been had by Consulting Health Dept (50 Tons stone used)

E. G. Stevenson

Sanitarian