IREDELL COUNTY HEALTH DEPARTMENT

Statesville Phone TR 3-7271 Mooresville Phone NO 3-1271

PERMIT TO INSTALL SEPTIC TANK

Permit No. 58 Permit Date 8-14 1972

Owner Jarlton & Rinaldo Address Statesville NC

Installed By Same Address


Location of Property out Hwy 90 above Long I.L. into Carol-Lynn Acres. Lot # 27

Tank		Capacity		Length of Lines		Fixtures	
Block	( )	1000	(✓)	225'	( )	No. of Baths	(1½)
Precast	(✓)	1250	( )	250'	( )	Dishwasher	( )
		1500	( )	Other 300 900 sq ft		Garbage Grdr.	( )
		Other				Other	

NOTIFY HEALTH DEPARTMENT AT LEAST EIGHT HOURS BEFORE TANK IS TO BE INSPECTED.

Final Inspection 8-14 1972 Approved (✓) Disapproved ( )

Remarks Alexander Water Corp

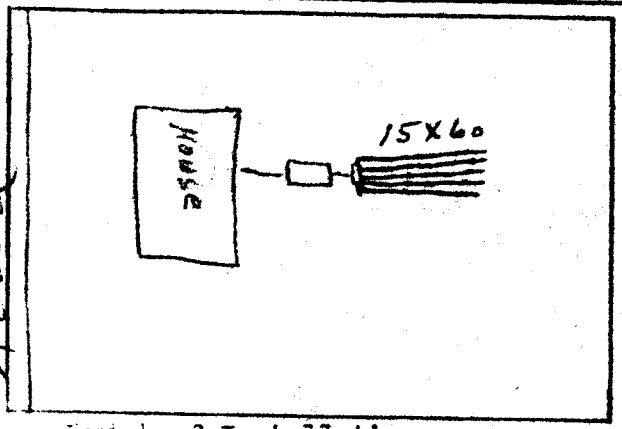

Sketch of Installation

E. G Stevenson

Sanitarian