IREDELL COUNTY HEALTH DEPARTMENT

Statesville Phone TR 3-7271 Mooresville Phone NO 3-1271

PERMIT TO INSTALL SEPTIC TANK

Permit No. 64 Permit Date 8-15 1972

Owner Tarlton & Rinaldo Address Statesville NC

Installed By Owner Address

Location of Property Out Hwy # 90 above Searcy - T.L. into Carol Lynn Acres


1st House on L Lot # 50

Tank		Capacity		Length of Lines		Fixtures	
Block	( )	1000	(✓)	225'	( )	No. of Baths	(1½)
Precast	(✓)	1250	( )	250'	( )	Dishwasher	(✓)
		1500	( )	Other 300' 800 sq ft		Garbage Grdr.	( )
		Other				Other	

NOTIFY HEALTH DEPARTMENT AT LEAST EIGHT HOURS BEFORE TANK IS TO BE INSPECTED.

Final Inspection 8-15 1972 Approved (✓) Disapproved ( )

Remarks ~~Community Water~~ - Alexander Water Corp.

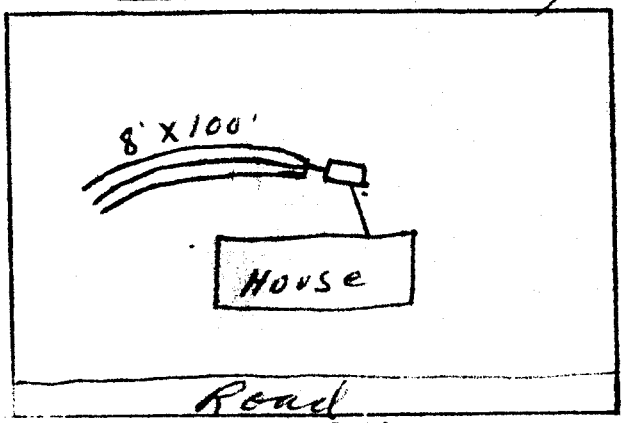

Sketch of Installation

E. G. Stevenson

Sanitarian