CONLEY'S LLP

IREDELL COUNTY HEALTH DEPARTMENT

STATESVILLE 704-878-5305 MOORESVILLE 704-664-5281

IMPROVEMENT PERMIT / AUTHORIZATION TO CONSTRUCT / OPERATION PERMIT / EXISTING SYSTEM INSPECTION

PERMIT# 081179 PIN# 4715 28 8971 (PT) DATE 5-12-99

OWNER OR CONTRACTOR WILLIAM CONLEY PHONE: Business Home 872-0819

ADDRESS 369 MIDWAY ROAD, STATESVILLE, NC 28677

LOCATION NC 90 WEST, ON RIGHT, JUST PAST TARLTON ROAD (CROSS RR TRACKS)

SUBDIVISION BLOCK / SECTION LOT LOT AREA 5.3 ACRES SITE CLASS PS DESIGN FLOW 300 L.T.A.R. 0.35 GPD/FT²

Septic Tank: 1000 Gallons; STB 794 Date 2-15-99
Pump Tank: 1000 Gallons; PT 27 Date 2-12-99
Pump Make: Model Serial No.
Nitrification Field: No Fields 1 Square Feet 855 Linear Feet 285
No Lines THREE Trench Width 36" Max Trench Bottom Depth 36" Gravel Depth 12"

☑ New System ☐ Repair System Type: I, II, III, IV, V, VI
System Description: CONVENTIONAL, PUMP
Repair System Description: CONV, PUMP
Maintenance Agreement Required: ☐ Yes ☑ No


☐ House/Mod. Home No. Bedrooms
☐ Mobile Home No. Bathrooms
☑ Business No. Employees 12
☐ Other
☐ Slab ☐ Crawl Space ☐ Basement w/plumbing ☐ Basement wo/plumbing

Water Supply: ☐ Individual ☑ Public ☐ Community WELL

Comments/Conditions: ① USE SEPTIC TANK & PUMP TANK WITH ADDITIONAL REINFORCEMENT FOR VEHICULAR TRAFFIC ② SEE ATTACHED SHEETS FOR PUMP & PRESSURE REQUIREMENTS

Comments/Conditions
7-27 ~~marked~~ / inspected drain lines
8-12 checked tanks

INITIAL SITE SKETCH

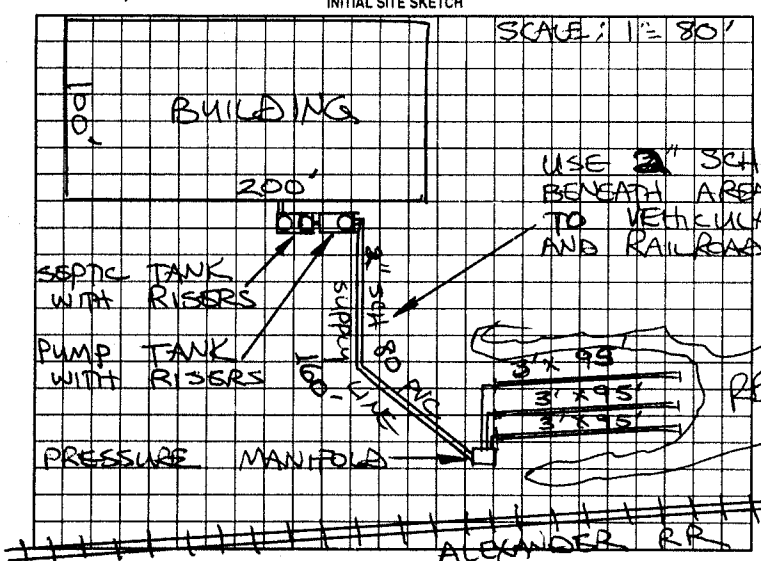

AS BUILT SKETCH

SYSTEM INSTALLED ACCORDING TO INITIAL SITE SKETCH

Permit can be suspended or revoked if any false information is supplied toward securing the permit/any unauthorized changes are made to the site/any unauthorized changes are made in the installation of the system. Improvement Permit with plat valid without expiration. Improvement Permit with site plan valid for sixty months. Authorization to Construct is valid for a period equal to that of Improvement Permit – not to exceed sixty months.

Signed: + William Conley, Jr. date 5-12-99
Improvement Permit by: STEVE HENDRICK date 5-12-99
Authorization to Construct by: STEVE HENDRICK date 5-12-99

Installed by: JAMES HUMER
Operation Permit by: STEVE HENDRICK date 10-12-99
Existing System Inspection by: date

HEALTH DEPT. COPY: WHITE OWNER COPY (FINAL) YELLOW OWNER COPY (INITIAL) PINK