IREDELL COUNTY HEALTH DEPARTMENT

Statesville Phone TR 3-7271 Mooresville Phone NO 3-1271

PERMIT TO INSTALL SEPTIC TANK

Permit NO. Prichard-Contractor Permit Date 8-19 1959

Owner Blake Mosen Address Route 6

Installed By C. Hake Address Route 7


Location of Property Left off 90 at little Trailer & Store. Cross Creek - right on 1st dirt [illegible] before X Rd.

Tank		Capacity		Length of Lines		Fixtures	
Block	( )	800	(✓)	150'	(✓)	No. of Baths	( )
Precast	(✓)	900	( )	175'	( )	Dishwasher	( )
		1000	( )	200'	( )	Garbage Grdr.	( )
		1100	( )	225'	( )	Auto-Washer	( )
		1200	( )	250'	( )	Other	
		Other		Other			

NOTIFY HEALTH DEPARTMENT AT LEAST EIGHT HOURS BEFORE TANK IS TO BE INSPECTED.

Final Inspection 8-19 1959 Approved ( ) Disapproved ( )

Remarks Not for washer. Self open

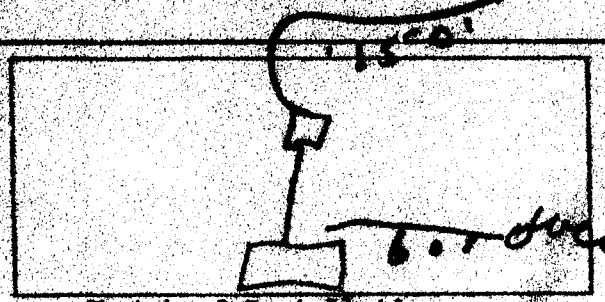

Sketch of Installation

Sanitarian