IREDELL COUNTY HEALTH DEPARTMENT

STATESVILLE 704-878-5305 MOORESVILLE 704-664-5281

IMPROVEMENT PERMIT / CERTIFICATE OF COMPLETION / OPERATION PERMIT / EXISTING SYSTEM INSPECTION

PROPERTY DESCRIPTION NO. 18186 DATE 4/11/94 TAX MAP NO. 8T-3-A-21

OWNER OR CONTRACTOR MELVIN WITMER PHONE: Business Home (216) 669-3729 Watershed: ☐ Yes ☑ No

ADDRESS P.O. BOX 194, SMITHVILLE, OH 44677

LOCATION NC 90 W, TL WOODBRIDGE, TR DELAWARE, TR WESTRIDGE, 10TH LOT ON (L)

SUBDIVISION WESTRIDGE BLOCK / SECTION II LOT 21 LOT AREA 1.2365 AC SITE CLASS. PS DESIGN FLOW 360 L.T.A.R. 0.35 GPD/FT²

Septic Tank: 1000 Gallons; STB 794 Date 6/19/94
Pump Tank: ____ Gallons; PT ____ Date ____
Pump Make: ____ Model ____ Serial No. ____
Nitrification Field: No Fields 1 Square Feet 1035 Linear Feet 345
No Lines 4 Trench Width 36" Max Trench Bottom Depth 28" Gravel Depth 12"

☑ New System ☐ Repair System Type: I, II, III, IV, V, VI
System Description: CONVENTIONAL GRAVITY
Repair System Description: CONVENTIONAL GRAVITY
Maintenance Agreement Required: ☐ Yes ☑ No
☐ Slab ☑ Crawl Space ☐ Basement w/plumbing ☐ Basement wo/plumbing


☐ House/Mod. Home ☑ Mobile Home ☐ Business ☐ Other
No. Bedrooms 3 No. Bathrooms 2 No. Employees ____

Water Supply: ☑ Individual ☐ Community ☐ Public WELL


Comments: (1) KEEP SYSTEM MINIMUM 10' FROM PROPERTY LINE, 5' FROM MH, 80' FROM WELL (2) INSTALL LINES NO DEEPER THAN 28" ALONG THE CONTOUR OF GROUND SURFACE

Comments:

INITIAL SITE SKETCH

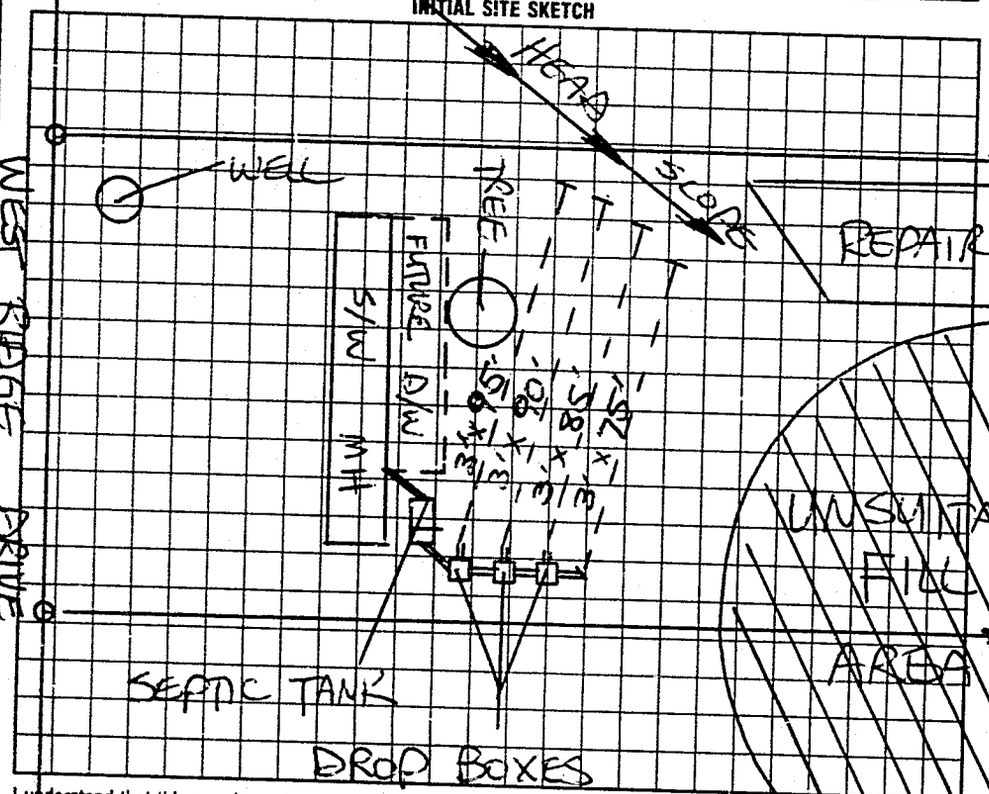

AS BUILT SKETCH

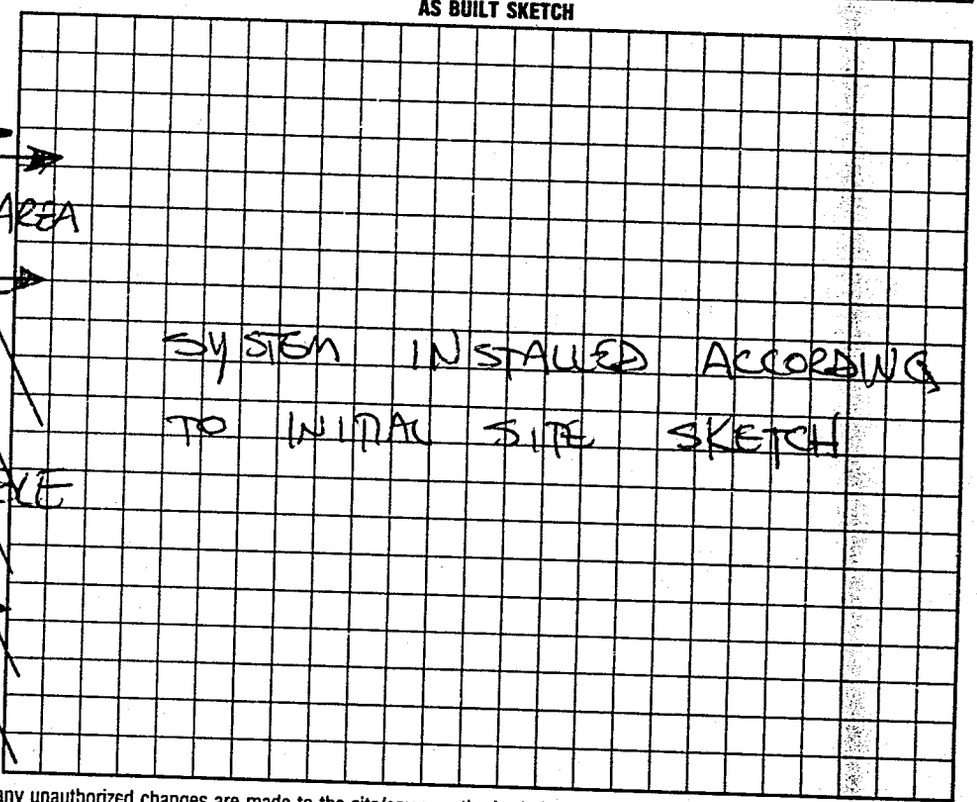

I understand that this permit can be suspended or revoked if any false information is supplied toward securing the permit/any unauthorized changes are made to the site/any unauthorized changes are made in the installation of the system. Improvement Permit is valid for 60 months from date of issuance.

Signed: X Melvin Witmer

Improvement Permit by: STEVE HEDRICK date 4/11/94

Existing System Inspection by: ____ date ____

Installed by: A-1 BACKHOE

Certificate of Completion by: STEVE HEDRICK date 8/1/94

Operation Permit by: ____ date ____

HEALTH DEPT. COPY: WHITE INSPECTION COPY (FINAL): GREEN OWNER COPY (FINAL): YELLOW INSPECTION COPY (INITIAL): PINK OWNER COPY (INITIAL): GOLD