Houston

IREDELL COUNTY HEALTH DEPARTMENT

STATESVILLE 704-878-5305 MOORESVILLE 704-664-5281

IMPROVEMENT PERMIT / AUTHORIZATION TO CONSTRUCT / OPERATION PERMIT / EXISTING SYSTEM INSPECTION

PERMIT # 15513 PIN # 4715-31-5117 DATE 3-10-09

OWNER or APPLICANT Caroline Houston PHONE: Business Home: 704-871-8229

OWNER or APPLICANT ADDRESS 158 West Ridge Drive

LOCATION / DIRECTIONS left on Woodbridge RD Right on Westridge TR Westridge

SUBDIVISION West Ridge BLOCK / SECTION II LOT # 35 LOT AREA .56 AC DESIGN FLOW 360 L.T.A.R. .35 (EVAL)

Septic Tank 1000 (EVAL) Gallons: STB 794 (EVAL) Date 6/10/24 (EVAL) ☑ New System ☐ Repair ☐ Expansion System Type I II III IV V VI

Pump Tank Gallons: PT Date

Pump Make Model Serial #

System Description: EVAL (Conventional Trench)

Repair System Description: 25% Reduction

Nitrification Field No Fields 1 No Lines 4 Linear Feet 345 (EVAL)

Trench Width 36 Max. Trench Bottom Depth 23 Gravel Depth 12"

Maintenance Agreement Required ☐ YES ☐ NO ☐ GRAVITY ☐ PRESSURE

☐ Residence No. Bedrooms 3 ☐ Business No. Persons ☐ Other No. Employees ☐ Slab ☑ Crawl Space ☐ Basement w/plumbing ☐ Basement w/o plumbing

Water Supply ☑ Private ☐ Public ☐ Community


Comments / Conditions

New Mobile home exactly where old one was

No Structure built over Septic lines


Septem not failing at time of inspection.

INITIAL SITE SKETCH

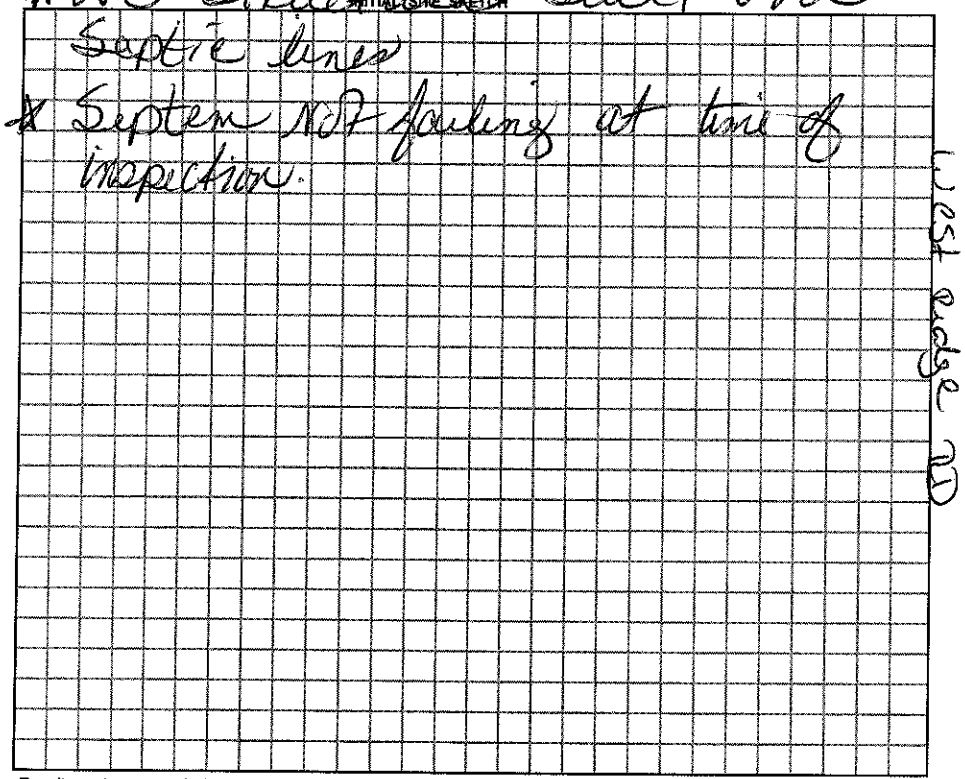

Comments / Conditions

AS BUILT SKETCH

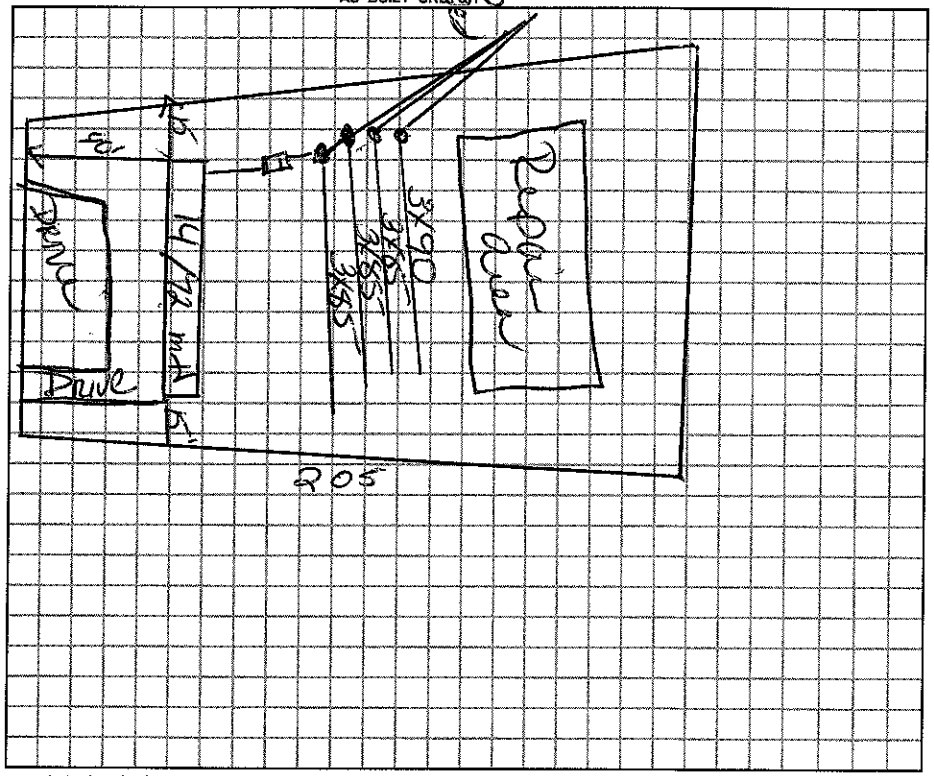

Permit can be suspended or revoked if any false information is supplied toward securing the permit / any unauthorized changes are made to the site / any unauthorized changes are made in the installation of the system.

☐ *IMPROVEMENT PERMIT w / plat valid without expiration.* ☐ *IMPROVEMENT PERMIT w / site plan valid for 60 mos.* ☐ *AUTHORIZATION TO CONSTRUCT valid for period equal to IMPROVEMENT PERMIT-not to exceed 60 mo.*

Owner / Applicant Signature: Date

Improvement Permit by: Date

Authorzation to Construct by: Date

YOU SHOULD CONTACT A LOCATOR SERVICE PRIOR TO ANY EXCAVATION.

Installed by:

Operation Permit by: Date:

Existing System Inspected by: Date: 3-10-09

WHITE COPY Environmental Health YELLOW COPY (Final) Owner / Applicant PINK COPY (Initial) Owner / Applicant