IREDELL COUNTY HEALTH DEPARTMENT

STATESVILLE 704-878-5305 MOORESVILLE 704-664-5281

IMPROVEMENT PERMIT / CERTIFICATE OF COMPLETION / OPERATION PERMIT / EXISTING SYSTEM INSPECTION

PROPERTY DESCRIPTION NO. 17903 DATE 3-23-94 TAX MAP NO. 8T-3-A-31 Watershed: ☐ Yes ☑ No

OWNER OR CONTRACTOR Nancy J. Lineberger PHONE: Business _____ Home 878-2460

ADDRESS 3785 Miller Farm Rd. Statesville, N.C. 28677

LOCATION I-40W TR Stamey Farm Rd TL Island Ford Rd. TR Woodbridge Rd TL Delaware Rd TR Westridge Dr 6th Lot on R

SUBDIVISION Westridge S/D BLOCK / SECTION — LOT 31 LOT AREA 20,000 sq.ft. SITE CLASS. P.S. DESIGN FLOW 360 L.T.A.R. .35 gpd/ft²

Septic Tank: 1000 Gallons; STB 782 Date 3/23/94

Pump Tank: 1000 Gallons; PT 1103 Date 4/15/93

Pump Make: GOULDS Model 3887 W30 11/2E Serial No. 2748457

Nitrification Field: No Fields 1 Square Feet 1035 Linear Feet 345'

No Lines 5 Trench Width 36" Max Trench Bottom Depth 30" Gravel Depth 12"

☑ New System ☐ Repair System Type: I, II, III, IV, V, VI

System Description: conventional, pump to pressure manf.

Repair System Description: pump to PPBPS

Maintenance Agreement Required: ☐ Yes ☑ No

☐ House/Mod. Home ☐ Mobile Home ☐ Business ☐ Other

No. Bedrooms 3 No. Bathrooms 2 No. Employees ____


Water Supply: ☑ Individual ☐ Community ☐ Public

☐ Slab ☑ Crawl Space ☐ Basement w/plumbing ☐ Basement wo/plumbing

Comments: Pump to pressure manifold (see attached) INSTALL SYSTEM SHALLOW (no deeper than 30" to trench bottom) Keep Nitrification Lines and Trenches on contour. Keep system 5' from foundation of home, 10' from all property lines, and 50' from any well.

Comments: Pump and pump tank diagram attached.

INITIAL SITE SKETCH

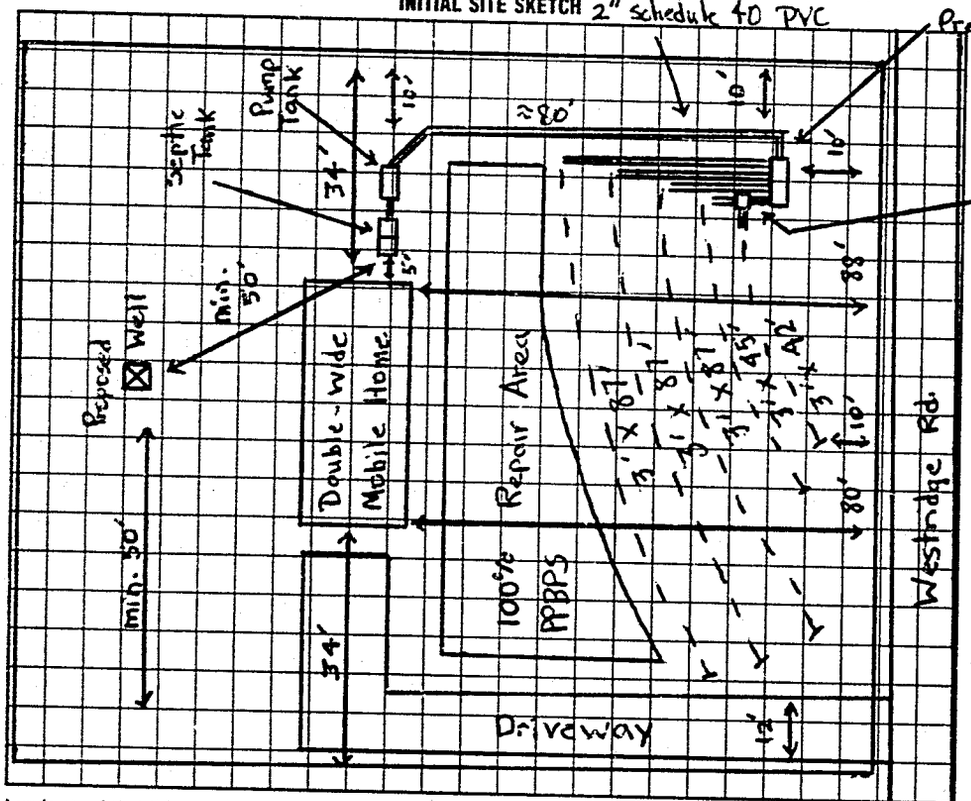

AS BUILT SKETCH

100% Repair Area

Pump to PPBPS.

SAME AS INITIAL SKETCH.

Drain lines, tanks, floats, and pressure head inspected on 5-2-94 Nema 4X Box and Alarm inspected on 2-6-95.

Contractor did not have NEMA 4X Box and Alarm ready at time of inspection on 5-2-94. He was to call back when they were ready. He never called back and operation permit was never issued. Power was allowed to be turned on without us being notified of the O.P. being issued. For this reason we were never called back. I, Mike Dennis, made inspection on 2-6-95 and found both NEMA 4X Box and Alarm in proper locations with alarm testing O.K. The Inspection made on 5-2-94 was done by Steve Hedrick.

I understand that this permit can be suspended or revoked if any false information is supplied toward securing the permit/any unauthorized changes are made to the site/any unauthorized changes are made in the installation of the system. Improvement Permit is valid for 60 months from date of issuance.

Signed: X Nancy J. Lineberger

Improvement Permit by: Michael J. Dennis date 3-24-94

Existing System Inspection by: _____ date _____

Installed by: DONALD LACKEY

Certificate of Completion by: _____ date _____

Operation Permit by: Steve Hedrick / Michael J. Dennis date 2-6-95

HEALTH DEPT. COPY: WHITE INSPECTION COPY (FINAL): GREEN OWNER COPY (FINAL): YELLOW INSPECTION COPY (INITIAL): PINK OWNER COPY (INITIAL): GOLD