IREDELL COUNTY HEALTH DEPARTMENT

STATESVILLE 704-878-5305 MOORESVILLE 704-664-5281

IMPROVEMENT PERMIT / AUTHORIZATION TO CONSTRUCT / OPERATION PERMIT / EXISTING SYSTEM INSPECTION

PERMIT# 083150 PIN# 4715 31 7372 DATE 8-10-99

OWNER OR CONTRACTOR LEWIS PIERCE PHONE: Business Home 873-3671

ADDRESS 289 WOOD BRIDGE ROAD, STATESVILLE, NC 28625

LOCATION US 64 W, TL WOOD BRIDGE ROAD, ON RIGHT AT BOX # 289

SUBDIVISION BLOCK / SECTION LOT LOT AREA 0.77 ACRE SITE CLASS P3 DESIGN FLOW 360 L.T.A.R. EXISTING 0.33

Septic Tank: 1000 Gallons; STB Date

Pump Tank: Gallons; PT Date

Pump Make: Model Serial No.

Nitrification Field: No Fields 1 Square Feet 360 Linear Feet 120

No Lines ONE Trench Width 36" Max Trench Bottom Depth 36" Gravel Depth 12"

☑ New System ☐ Repair System Type: I, II, III, IV, V, VI

System Description: CONVENTIONAL GRAVITY

Repair System Description: CONV. GRAVITY

Maintenance Agreement Required: ☐ Yes ☑ No

☐ House/Mod. Home ☑ Mobile Home ☐ Business ☐ Other

No. Bedrooms 3 No. Bathrooms 2 No. Employees


☐ Slab ☑ Crawl Space ☐ Basement w/plumbing ☐ Basement wo/plumbing

Water Supply: ☑ Individual ☐ Public ☐ Community WELL


Comments/Conditions: PUMP-OUT EXISTING SEPTIC TANK, REPLACE SANITARY-TEE IF NECESSARY

Comments/Conditions:

INITIAL SITE SKETCH

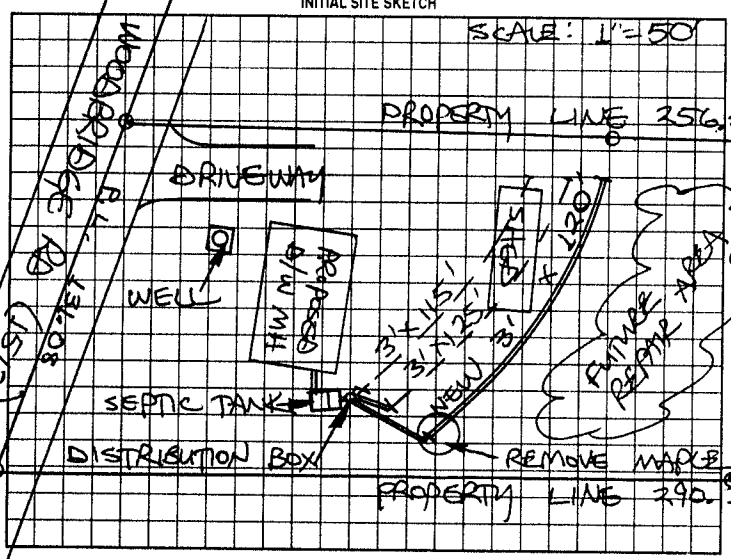

AS BUILT SKETCH

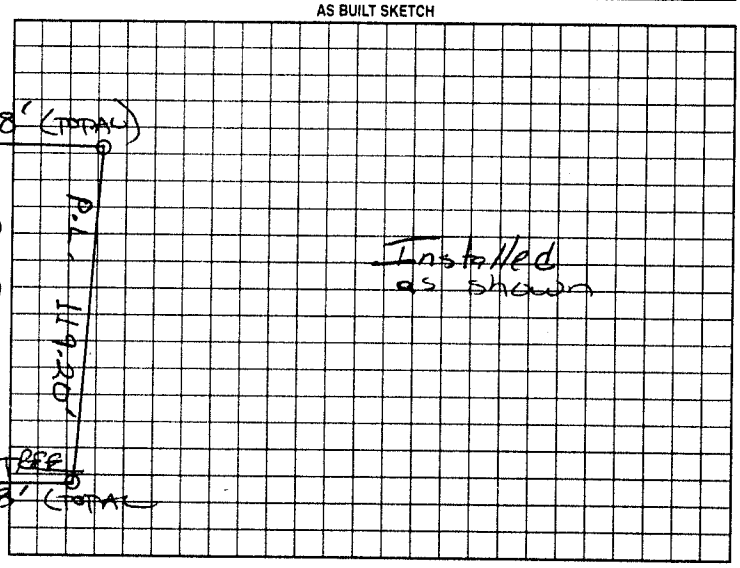

Permit can be suspended or revoked if any false information is supplied toward securing the permit/any unauthorized changes are made to the site/any unauthorized changes are made in the installation of the system. Improvement Permit with plat valid without expiration. Improvement Permit with site plan valid for sixty months. Authorization to Construct is valid for a period equal to that of Improvement Permit – not to exceed sixty months.

Signed: Stella M. Pierce date 8-10-99

Improvement Permit by: STEVE HEDRICK date 8-10-99

Authorization to Construct by: STEVE HEDRICK date 8-10-99

Installed by: Berry Sigmon

Operation Permit by: Mary C Oates date 8-31-99

Existing System Inspection by: date

HEALTH DEPT COPY: WHITE OWNER COPY (FINAL) YELLOW OWNER COPY (INITIAL) PINK