IREDELL COUNTY HEALTH DEPARTMENT

STATESVILLE 704-878-5305 MOORESVILLE 704-664-5281

IMPROVEMENT PERMIT / AUTHORIZATION TO CONSTRUCT / OPERATION PERMIT / EXISTING SYSTEM INSPECTION

PERMIT# Repair PIN# 4715-31-8402 DATE 5-21-04

OWNER OR CONTRACTOR Thomas Dye PHONE: Business Home (704) 872-5806

ADDRESS 295 Wood Bridge Rd. Statesville NC 28625

LOCATION I-40W TR Hwy 90 TL Wood Bridge Rd. Cross 3RD Creek Bridge and come to top of hill. 2ND white house on right 295 Wood Bridge

SUBDIVISION BLOCK / SECTION LOT LOT AREA .5 SITE CLASS. ps DESIGN FLOW 240 L.T.A.R. Ex.

Septic Tank: Ex. Gallons; STB Date

Pump Tank: Gallons; PT Date

Pump Make: Model Serial No.

Nitrification Field: No Fields 1 Square Feet Linear Feet 200'

No Lines 3 Trench Width 36" Max Trench Bottom Depth 36" Gravel Depth 16"

☐ New System ☑ Repair System Type: I, (II), III, IV, V, VI

System Description: C

Repair System Description: Con. Gravity

Maintenance Agreement Required: ☐ Yes ☑ No

☑ House/Mod. Home No. Bedrooms 2

☐ Mobile Home No. Bathrooms 1

☐ Business No. Employees

☐ Other

☐ Slab ☐ Crawl Space ☐ Basement w/plumbing ☐ Basement wo/plumbing


Water Supply: ☑ Individual ☐ Public ☐ Community

Comments/Conditions: ① Install lines on contour ② Supply line will require approx. 85' ductile iron pipe due to encroachment of the 50' setback ③ Wants to save trees.


Comments/Conditions: ① #5 stone ② Decided to go w/ abandonment of well and use 3" sch 40 pipe

Scale 1" = 60'

INITIAL SITE SKETCH

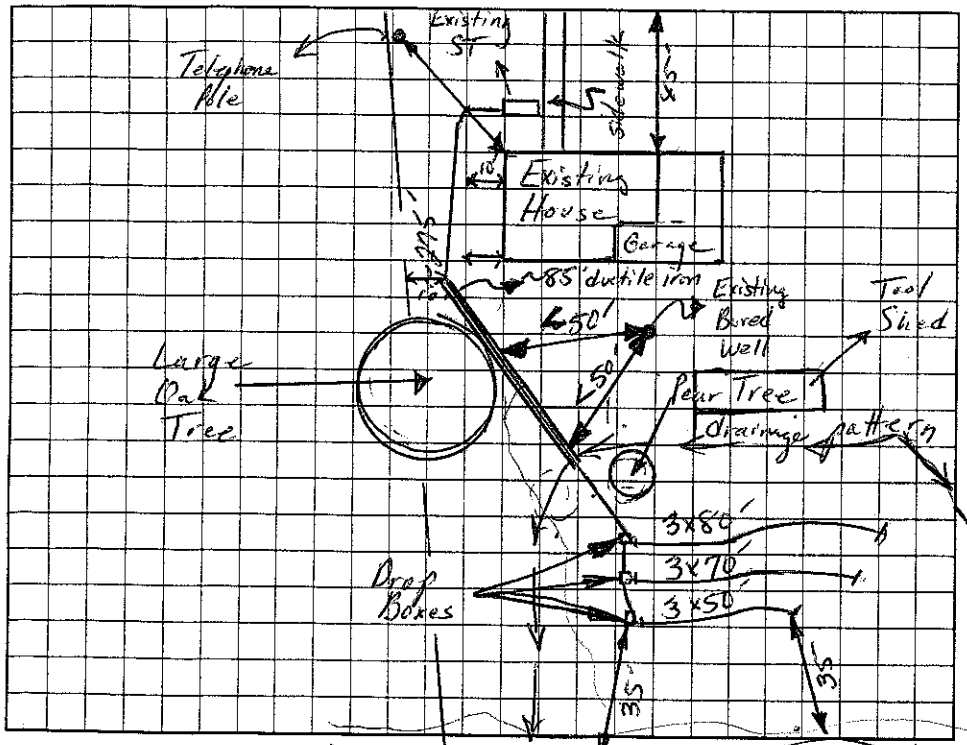

AS BUILT SKETCH

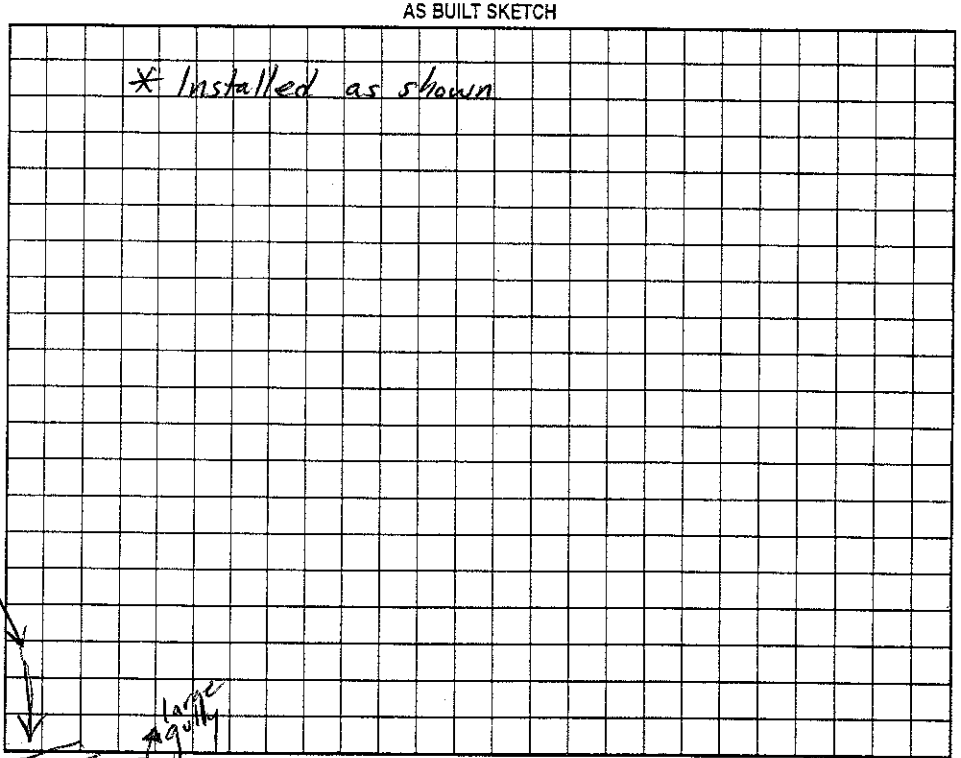

Permit can be suspended or revoked if any false information is supplied toward securing the permit/any unauthorized changes are made to the site/any unauthorized changes are made in the installation of the system. Improvement Permit with plat valid without expiration. Improvement Permit with site plan valid for sixty months. Authorization to Construct is valid for a period equal to that of Improvement Permit – not to exceed sixty months.

Signed: Thomas Dye date 5/24/04 Installed by: Union Grove Septic

Improvement Permit by: Christopher M. Shuping, RS date 5-25-04 Operation Permit by: Christopher M. Shuping, RS date 7-8-04

Authorization to Construct by: Christopher M. Shuping date 5-25-04 Existing System Inspection by: date

HEALTH DEPT. COPY: WHITE OWNER COPY (FINAL): YELLOW OWNER COPY (INITIAL): PINK