IREDELL COUNTY HEALTH DEPARTMENT

STATESVILLE 704-878-5305 MOORESVILLE 704-664-5281

IMPROVEMENT PERMIT / AUTHORIZATION TO CONSTRUCT / OPERATION PERMIT / EXISTING SYSTEM INSPECTION

PERMIT# 92321 PIN# 4715 37 1276 DATE 10/20/00

OWNER OR CONTRACTOR Clayton Homes PHONE: Business 873-2547 Home

ADDRESS 2026 Northside Dr. Statesville NC 28625

LOCATION Hwy 90, L Intrepid at end on RT

SUBDIVISION BLOCK / SECTION LOT LOT AREA .91 AC SITE CLASS PS DESIGN FLOW 360 L.T.A.R. 0.5

Septic Tank: Existing Gallons: STB Date

Pump Tank: Gallons: PT Date

Pump Make: Model Serial No.

Nitrification Field: No Fields 1 Square Feet 375 Linear Feet Add 125

No Lines 2 Trench Width 36" Max Trench Bottom Depth 36" Gravel Depth 12"

☐ New System ☐ Repair System Type: I, (II), III, IV, V, VI

System Description: Add Conv. Lines

Repair System Description: 25% Reduction

Maintenance Agreement Required: ☐ Yes ☒ No

☐ House/Mod. Home ☒ Mobile Home ☐ Business ☐ Other

No. Bedrooms 3 No. Bathrooms 2 No. Employees

☐ Slab ☒ Crawl Space ☐ Basement w/plumbing ☐ Basement wo/plumbing

Water Supply: ☒ Individual ☐ Public ☐ Community


Comments/Conditions:

10' From P/L

Not to Scale

Comments/Conditions:

INITIAL SITE SKETCH REPAIR

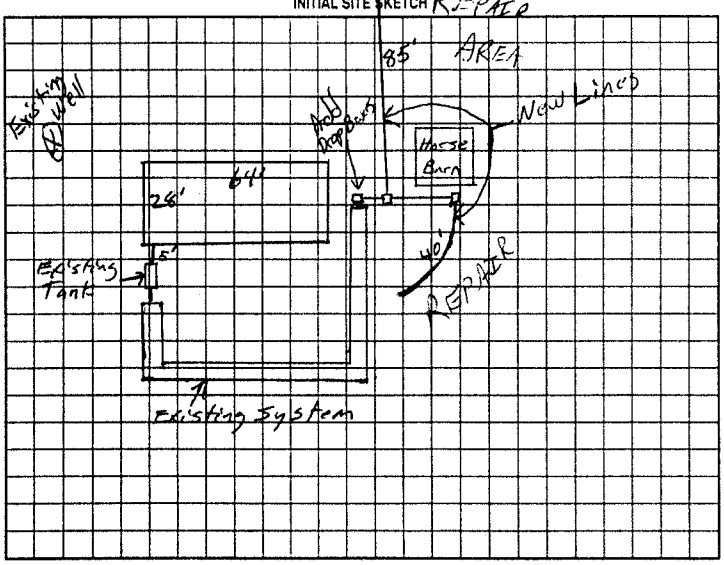

AS BUILT SKETCH

Permit can be suspended or revoked if any false information is supplied toward securing the permit/any unauthorized changes are made to the site/any unauthorized changes are made in the installation of the system. Improvement Permit with plat valid without expiration. Improvement Permit with site plan valid for sixty months. Authorization to Construct is valid for a period equal to that of Improvement Permit – not to exceed sixty months.

Signed: date 10/23/00 Installed by: A-1 Backhoe

Improvement Permit by: RSF date 10/20/00 Operation Permit by: RSF date 11/21/00

Authorization to Construct by: RSF date 10/20/00 Existing System Inspection by: date

HEALTH DEPT. COPY: WHITE OWNER COPY (FINAL): YELLOW OWNER COPY (INITIAL): PINK