IREDELL COUNTY HEALTH DEPARTMENT

STATESVILLE 704-878-5305 MOORESVILLE 704-664-5281

IMPROVEMENT PERMIT / AUTHORIZATION TO CONSTRUCT / OPERATION PERMIT / EXISTING SYSTEM INSPECTION

PERMIT# 102044 PIN# 4715-37-2703 DATE 8-27-01

OWNER OR CONTRACTOR JIMMY C. DELLINGER PHONE: Business _____ Home (704) 838-1728

ADDRESS 140 INTREPID DRIVE, STATESVILLE, NC 28625

LOCATION NC 90 WEST TO TL INTREPID LANE, BESIDE 1ST HOUSE ON RIGHT

SUBDIVISION _____ BLOCK / SECTION _____ LOT _____ LOT AREA 9.32 ACRES SITE CLASS PS DESIGN FLOW 240 L.T.A.R. EXISTING

Septic Tank: EXISTING Gallons; STB _____ Date _____

Pump Tank: _____ Gallons; PT _____ Date _____

Pump Make: _____ Model _____ Serial No _____

Nitrification Field: No Fields 1 Square Feet _____ Linear Feet EXISTING

No Lines BED Trench Width _____ Max Trench Bottom Depth _____ Gravel Depth _____

☐ New System ☐ Repair System Type: I (II) III IV V VI

System Description: CONVENTIONAL GRAVITY

Repair System Description: _____

Maintenance Agreement Required: ☐ Yes ☑ No

☐ Slab ☑ Crawl Space ☐ Basement w/plumbing ☐ Basement wo/plumbing

☑ House/Mod. Home ☑ Mobile Home ☐ Business ☐ Other

No. Bedrooms 2 No. Bathrooms 2 No. Employees ____


Water Supply: ☐ Individual ☐ Public ☐ Community

Comments/Conditions:

Comments/Conditions: SYSTEM UNDERSIZED ACCORDING TO TODAY'S STANDARDS

INITIAL SITE SKETCH

AS BUILT SKETCH

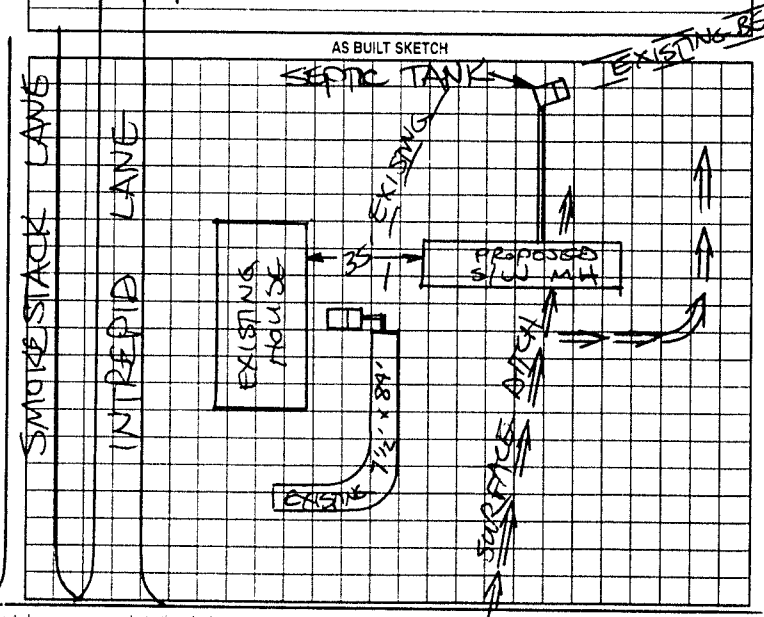

Permit can be suspended or revoked if any false information is supplied toward securing the permit/any unauthorized changes are made to the site/any unauthorized changes are made in the installation of the system. Improvement Permit with plat valid without expiration. Improvement Permit with site plan valid for sixty months. Authorization to Construct is valid for a period equal to that of Improvement Permit - not to exceed sixty months.

Signed: _____ date _____ Installed by: _____

Improvement Permit by: _____ date _____ Operation Permit by: _____ date _____

Authorization to Construct by: _____ date _____ Existing System Inspection by: STEVE HEDRICK date 8-27-01

HEALTH DEPT. COPY: WHITE OWNER COPY (FINAL): YELLOW OWNER COPY (INITIAL): PINK