IREDELL COUNTY HEALTH DEPARTMENT

Statesville Office (704) 878-5305 Mooresville Office (704) 660-3625 PERMIT # 206035

IMPROVEMENT PERMIT / AUTHORIZATION TO CONSTRUCT / OPERATION PERMIT / EXISTING SYSTEM

PIN # 4715277717

APPLICANT: John Woodside APPLICANT ADDRESS: 4017 Taylorsville Hwy

SITE ADDRESS: 4005 Taylorsville Hwy PHONE: 704-775-8846 ALT. PHONE: N/A

SITE DIRECTIONS: Hwy 90 W Property on Left before Tarlton Rd.

SUBDIVISION: N/A SECTION: N/A LOT # N/A LOT AREA: 1.093 acres DESIGN FLOW: 360gpd L.T.A.R.: 0.3

Septic Tank 1000 (gal) STB 160-1000 Date 8-27-15

Pump Tank (gal) PT Date

Pump Make Model Serial #

Nitrification Fields 1 # Lines 2 Linear Ft: 300

Trench Width 36" Max. Trench Bottom Depth 36" Gravel Depth N/A

☑ New System ☐ Repair ☐ Expansion System Type: I II III IV V VI

System Description: 25% Reduction

Repair System Description: Shallow 25% Reduction

Maintenance Agreement Required: ☐ YES ☑ NO

☑ GRAVITY ☐ PRESSURE


☑ Residence ☐ Business ☐ Other ☐ Slab ☐ Basement w/plumbing

No. Bedrooms 3 No. Persons 6 No. Employees Crawl Space ☐ Basement w/o plumbing


Water Supply: ☐ Private ☑ Public ☐ Community

Comments / Conditions: Install a 25% Reduction system on contour with serial distribution.

INITIAL SITE SKETCH

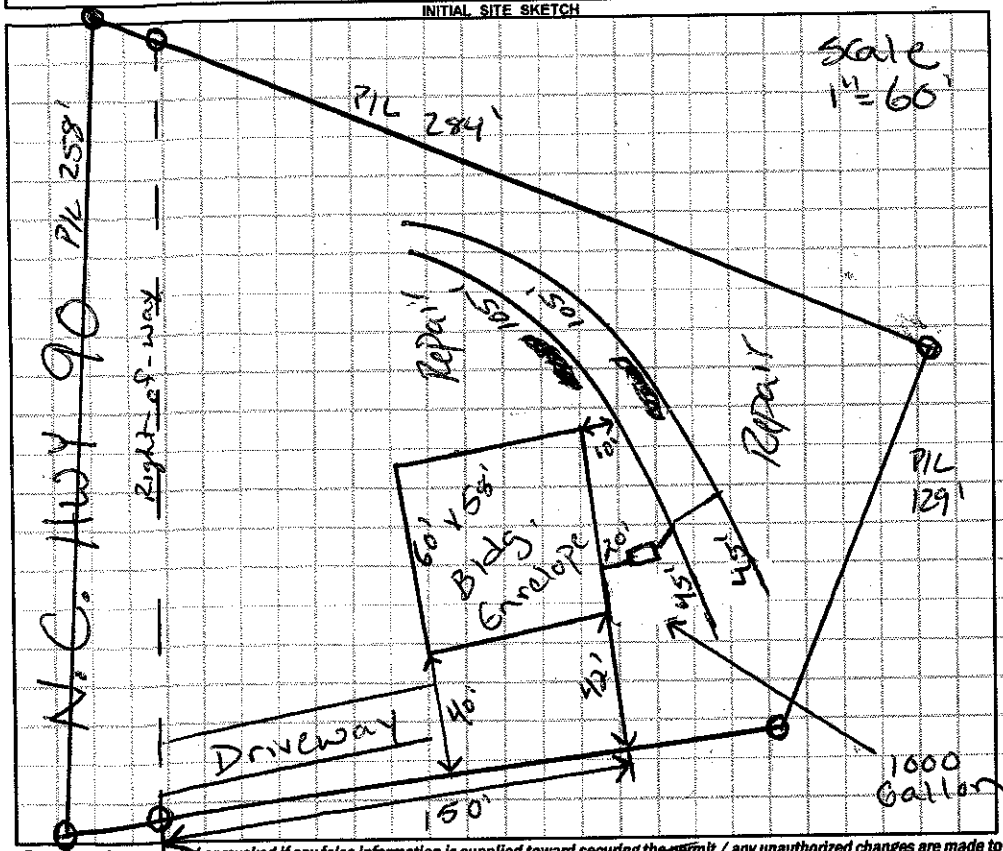

AS BUILT SKETCH

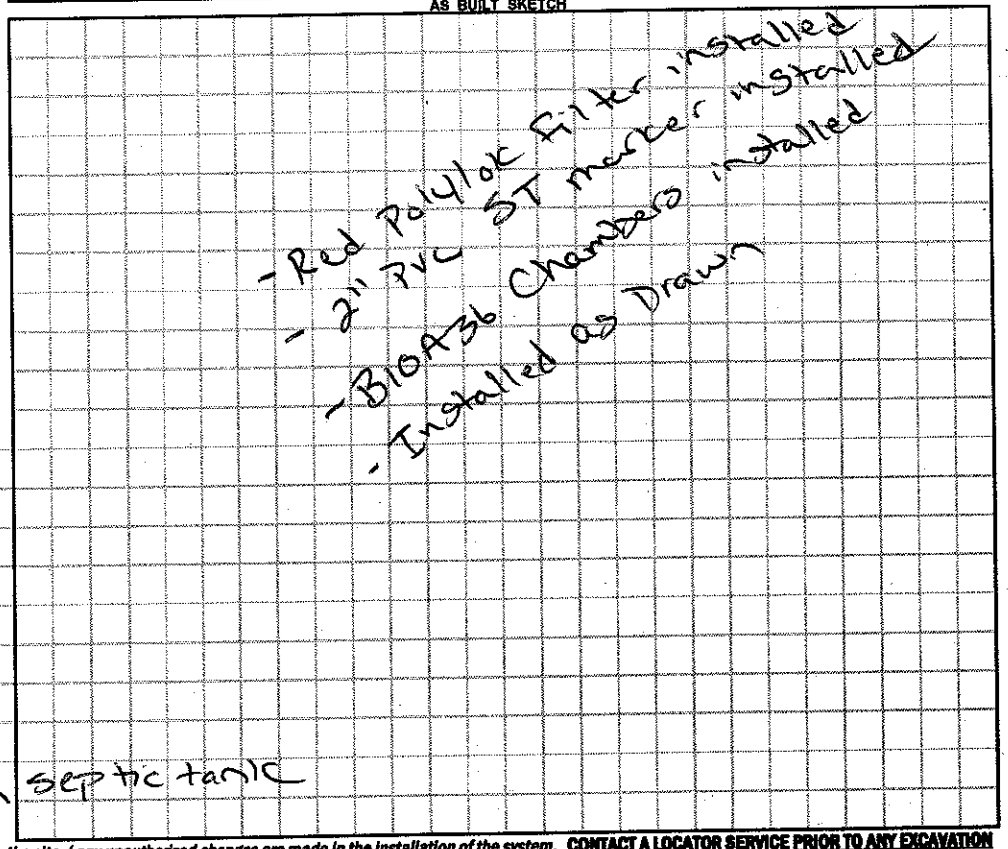

Permit can be suspended or revoked if any false information is supplied toward securing the permit / any unauthorized changes are made to the site / any unauthorized changes are made in the installation of the system. CONTACT A LOCATOR SERVICE PRIOR TO ANY EXCAVATION

☐ IMPROVEMENT PERMIT with plat valid without expiration. ☐ IMPROVEMENT PERMIT with site plan valid for 60 mos. ☑ AUTHORIZATION TO CONSTRUCT valid for period equal to IMPROVEMENT PERMIT--not to exceed 60 mo.

Owner / Applicant Signature: John Woodside Date: Installed by: Maiden Grading & Septic

IMPROVEMENT PERMIT by: Justin Henderson Date: 2-9-15 OPERATION PERMIT by: Justin Henderson Date: 11-24-15

AUTHORIZATION TO CONSTRUCT by: Justin Henderson Date: 2-9-15 Existing System Inspected by: Date:

Health Dept. Copy - WHITE Applicant (Final Approval) - YELLOW Applicant (Conditional Approval) - PINK