IREDELL COUNTY HEALTH DEPARTMENT

STATESVILLE 704-878-5305 MOORESVILLE 704-664-5281

EI

IMPROVEMENT PERMIT / AUTHORIZATION TO CONSTRUCT / OPERATION PERMIT / EXISTING SYSTEM INSPECTION

PERMIT# 15826 PIN# 4715-32-8073 4644 41-1755 DATE 1/6/04

OWNER OR CONTRACTOR County Line Home Center PHONE: Business (704) 838-1429 Home —

ADDRESS 590 Mocksville Hwy Statesville N.C. 28625

LOCATION I-40W, (R) Stoney Farm Rd to Stop Sign, (L) (L) Island Ford Rd (R) Woodbridge Rd 2nd Delware Rd, 5th House on Left

SUBDIVISION — BLOCK / SECTION — LOT — LOT AREA .46 Ac. SITE CLASS. PS DESIGN FLOW 360 L.T.A.R. .35 gpd/sq ft

Septic Tank: 4000 Gallons; STB 10:12 Date 8-11-03

Pump Tank: 1000 Gallons; PT 17 Date 7-26-03

Pump Make: Gould Model WE0511H Serial No. mo 374905

Nitrification Field: No Fields 1 Square Feet 1029 Linear Feet 343

No Lines 4@86ft Trench Width 36" Max Trench Bottom Depth 36" Gravel Depth 12"

☒ New System ☐ Repair System Type: I, II, (III) IV, V, VI

System Description: Pump, Conventional

Repair System Description: Pump, 25% Reduction

Maintenance Agreement Required: ☐ Yes ☒ No

☐ House/Mod. Home ☒ Mobile Home ☐ Business ☐ Other

No. Bedrooms 3 No. Bathrooms 2 No. Employees —


☐ Slab ☒ Crawl Space ☐ Basement w/plumbing ☐ Basement wo/plumbing

Water Supply: ☐ Individual ☒ Public ☐ Community

Comments:/Conditions: ① Keep ST + PT 100 Ft from wells ② Install Nitrification lines on Contour ② Install Supply line 18" under water line. ③ Install Supply line minimum 30 inches deep under driveways ④ See Attachments "A+B" ⑤ Maintain proper set backs

Comments:/Conditions: Checked lines Okay 2-20-04 wgf - Supply line Okay 2-24-04 wgf TURNDOWN TWICE 4-14-04 | ONCE 4-15-04 SET PRESSURE UNION IN TANK IS LEAKING + BOX IN HOUSE NEEDS LABELED AS BUILT SKETCH FOR ALARM. BOX OUTSIDE OK IT'S LABELED PUMP. LC 4-15-04 Union + Alarm Okay 4/23/04 wgf

INITIAL SITE SKETCH

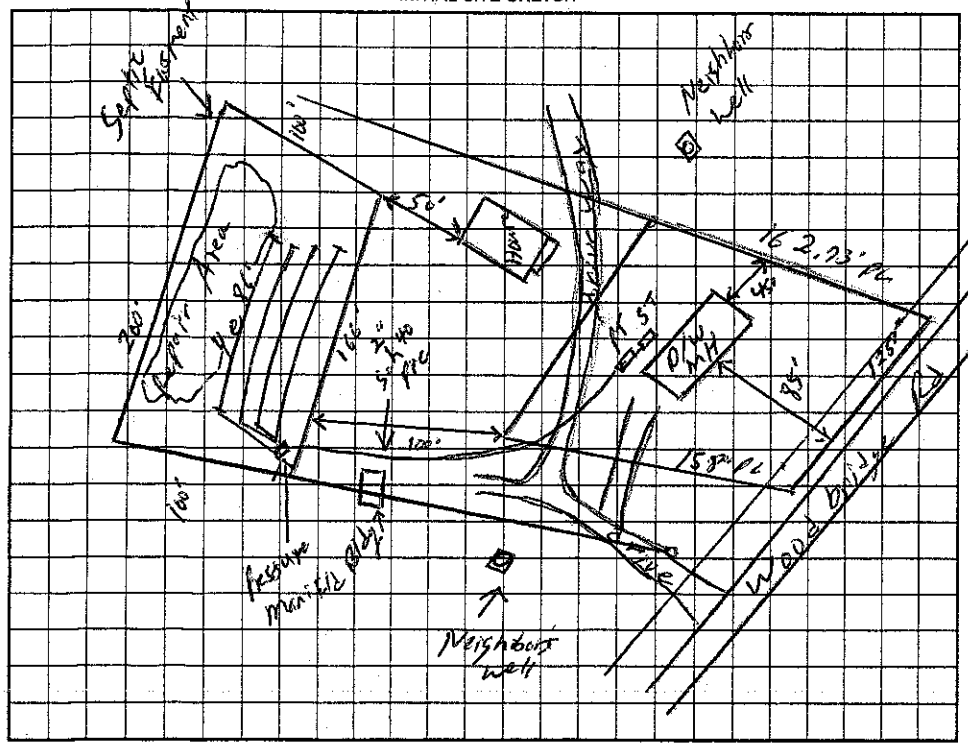

AS BUILT SKETCH

Installed As Shown per Initial Site Sketch

Permit can be suspended or revoked if any false information is supplied toward securing the permit/any unauthorized changes are made to the site/any unauthorized changes are made in the installation of the system. Improvement Permit with plat valid without expiration. Improvement Permit with site plan valid for sixty months. Authorization to Construct is valid for a period equal to that of Improvement Permit – not to exceed sixty months.

Signed: Jan Clarke for County Living Home Ctr date 1-6-04

Improvement Permit by: William O. Johnson date 1/6/04

Authorization to Construct by: William O. Johnson date 1/6/04

Installed by: C+S Grading

Operation Permit by: William O. Johnson date 4/23/04

Existing System Inspection by: _____ date _____

HEALTH DEPT. COPY: WHITE OWNER COPY (FINAL): YELLOW OWNER COPY (INITIAL): PINK