IREDELL COUNTY HEALTH DEPARTMENT

STATESVILLE 704-878-5305 (c1) MOORESVILLE 704-664-5281

IMPROVEMENT PERMIT / AUTHORIZATION TO CONSTRUCT / OPERATION PERMIT / EXISTING SYSTEM INSPECTION

(c) PERMIT# 14776 PIN# 4715-43-2996 DATE 8-20-07

OWNER OR APPLICANT NEX HOMES, LLC PHONE: Business 704-904-1998 Home 704-902-5684

ADDRESS P.O. BOX 4390, MOORESVILLE, NC 28117

LOCATION US 64 WEST, TL WOODBRIDGE ROAD, TR LORAY LANE, 2ND LOT ON LEFT

SUBDIVISION WOODBRIDGE EST, BLOCK / SECTION ____ LOT 1 LOT AREA 0.737 ACRE SITE CLASS. PS, DESIGN FLOW 360 L.T.A.R. 0.30 GPD/FT²

Septic Tank: 1000 Gallons; STB 312 Date 9-18-08

Pump Tank: ____ Gallons; PT ____ Date ____

Pump Make: ____ Model ____ Serial No. ____

Nitrification Field: No Fields 1 Square Feet 1200 Linear Feet 300

No Lines FOUR Trench Width 36" Max Trench Bottom Depth 36" Gravel Depth N/A

☑ New System ☐ Repair ☐ Expansion System Type: I (II) III IV V VI

System Description: 25% REDUCTION SYSTEM

Repair System Description: 25% REDUCTION, PUMP

Maintenance Agreement Required: ☐ Yes ☑ No

☑ House/Mod. Home No. Bedrooms 3

☐ Mobile Home No. Persons ____

☐ Business No. Employees ____

☐ Other ____


Water Supply: ☐ Individual ☑ Public ☐ Community

☑ Gravity ☐ Pressure ☐ Slab ☑ Crawl Space ☐ Basement w/plumbing ☐ Basement wo/plumbing


Comments/Conditions: INSTALL 25% REDUCTION SYSTEM ON CONTOUR AS SHOWN.

Comments/Conditions: SEPTIC TANK WITH MARKER INSTALLED USING RED "POLYLOK" FILTER

INITIAL SITE SKETCH

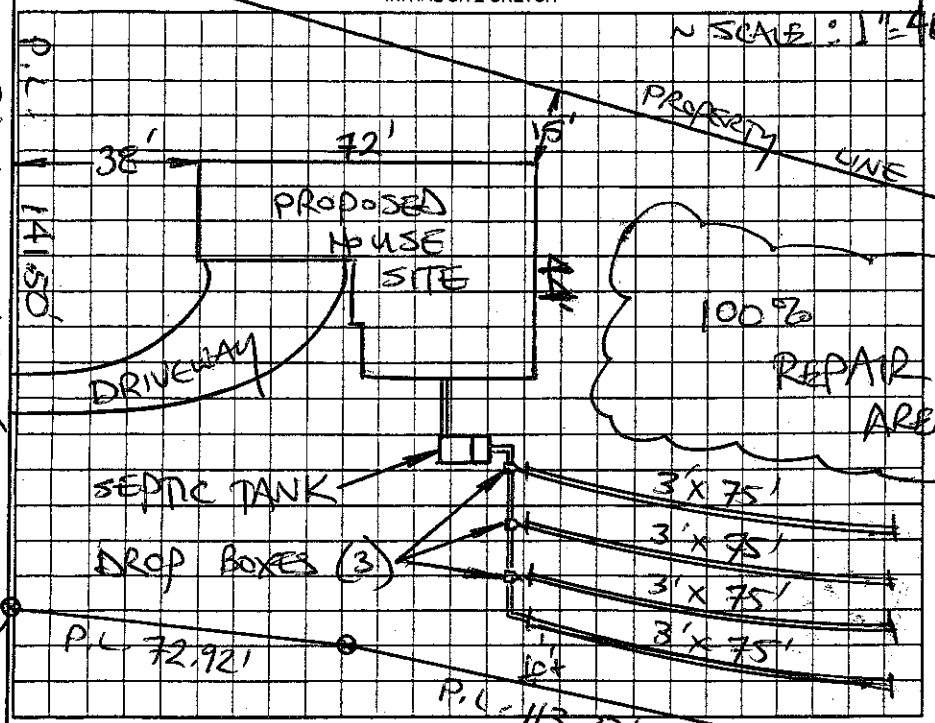

AS BUILT SKETCH

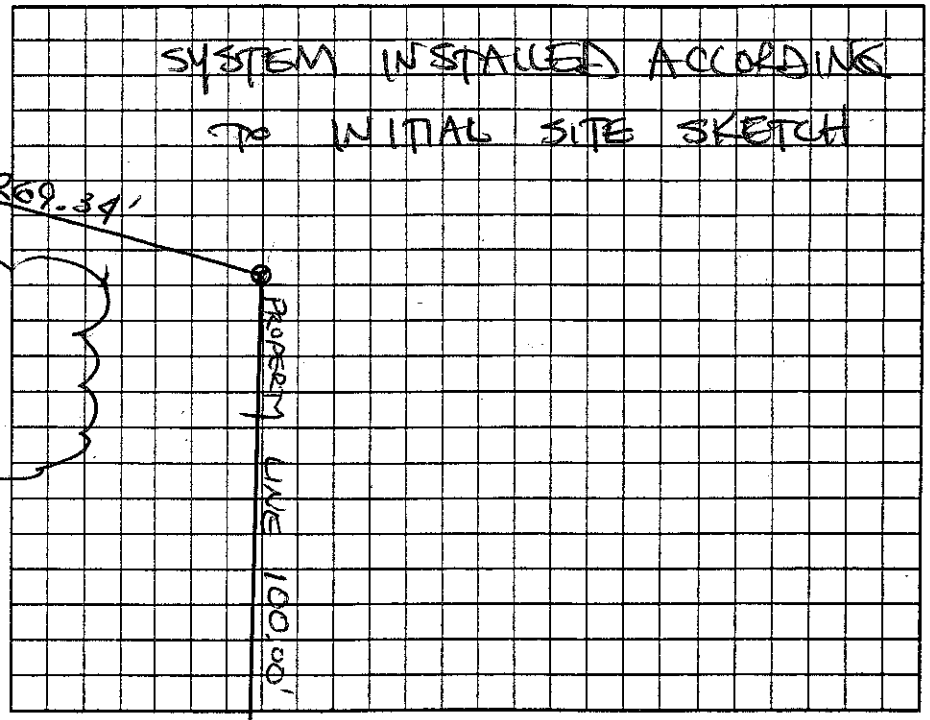

Permit can be suspended or revoked if any false information is supplied toward securing the permit/any unauthorized changes are made to the site/any unauthorized changes are made in the installation of the system. Improvement Permit with plan valid without expiration ☐ Improvement Permit with site plan valid for sixty months ☑ Authorization to Construct is valid for a period equal to that of Improvement Permit – not to exceed sixty months.

Signed: ____ 8-21-07 date ____ Installed by: RICHARD ABERNATHY

Improvement Permit by: STEVE HEDRICK date 8-20-07 Operation Permit by: STEVE HEDRICK date 6-4-08

Authorization to Construct by: STEVE HEDRICK date 8-20-07 Existing System Inspection by: ____ date ____

HEALTH DEPT. COPY: WHITE OWNER COPY (FINAL): YELLOW OWNER COPY (INITIAL): PINK