IREDELL COUNTY HEALTH DEPARTMENT

STATESVILLE 704-878-5305 MOORESVILLE 704-664-5281

IMPROVEMENT PERMIT / AUTHORIZATION TO CONSTRUCT / OPERATION PERMIT / EXISTING SYSTEM INSPECTION

PERMIT# 092808 PIN# 4715 43 5943 (PART) DATE 11-14-00

OWNER OR CONTRACTOR KEITH & JO ANNE HECK PHONE: Business Home (704) 361-1771

ADDRESS 421 WOOD BRIDGE ROAD, STATESVILLE, NC 28625

LOCATION US 64 W, TL WOOD BRIDGE RD, TR LORAN LANE, 2ND LOT ON LEFT

SUBDIVISION BLOCK / SECTION LOT LOT AREA 0.55 ACRES SITE CLASS. P5 DESIGN FLOW 360 L.T.A.R. 0.25 GAD/FT²

Septic Tank: 1000 Gallons; STB 1012 Date 9-9-00
Pump Tank: Gallons; PT Date
Pump Make: Model Serial No.
Nitrification Field: No Fields 1 Square Feet Ea. @ 1440 Linear Feet 360'
No Lines SIX Trench Width 36" Max Trench Bottom Depth 36" Gravel Depth SAND 6"

☑ New System ☐ Repair System Type: I, II, III, IV, V, VI
System Description: 25% REDUCTION PUMP
Repair System Description: 50% REDUCTION, PUMP
Maintenance Agreement Required: ☐ Yes ☑ No
☐ Slab ☑ Crawl Space ☐ Basement w/plumbing ☐ Basement wo/plumbing


☐ House/Mod. Home ☑ Mobile Home ☐ Business ☐ Other
No. Bedrooms 3 No. Bathrooms 2 No. Employees

Water Supply: ☑ Individual ☐ Public ☐ Community
WELL

Comments/Conditions: INSTALL SIXTY (60) CHAMBERS IN SIX EQUAL LENGTH LINES (AT REQUEST)

Comments/Conditions: SEPTIC TANK W/ RISERS INSTALLED USING "POLYLOK" FILTER

INITIAL SITE SKETCH

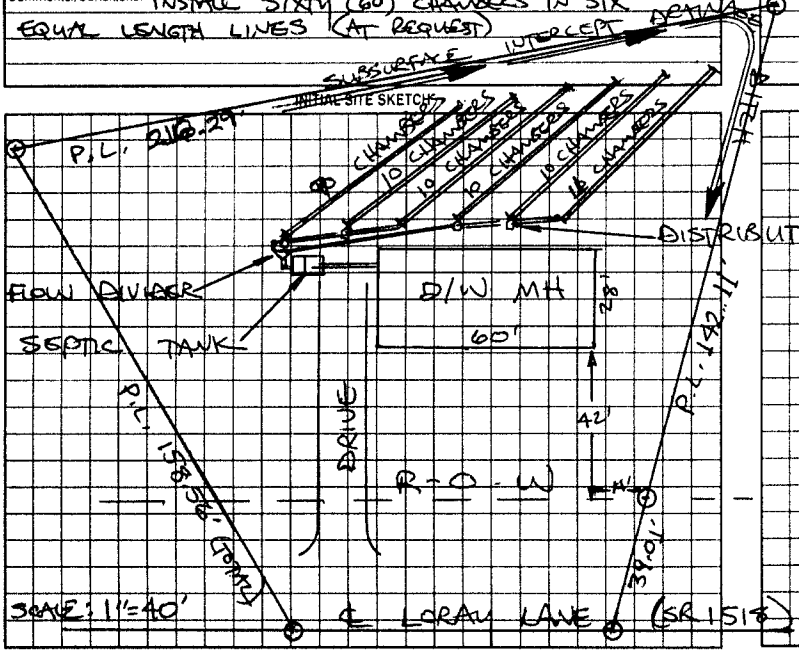

AS BUILT SKETCH

SYSTEM INSTALLED ACCORDING TO INIAL SITE SKETCH

Permit can be suspended or revoked if any false information is supplied toward securing the permit/any unauthorized changes are made to the site/any unauthorized changes are made in the installation of the system. Improvement Permit with plat valid without expiration. Improvement Permit with site plan valid for sixty months. Authorization to Construct is valid for a period equal to that of Improvement Permit – not to exceed sixty months.

Signed: [signature] date 11-15-00 Installed by: A-1 BACKHOE

Improvement Permit by: STEVE HEDRICK date 11-14-00 Operation Permit by: STEVE HEDRICK date 11-16-00

Authorization to Construct by: STEVE HEDRICK date 11-14-00 Existing System Inspection by: date

HEALTH DEPT COPY WHITE OWNER COPY (FINAL) YELLOW OWNER COPY (INITIAL) PINK