This Permit Replaces the Permit issued on 4-25-11

IREDELL COUNTY HEALTH DEPARTMENT

Statesville Office (704) 878-5305 Mooresville Office (704) 660-3625 PERMIT # 165380

IMPROVEMENT PERMIT / AUTHORIZATION TO CONSTRUCT / OPERATION PERMIT / EXISTING SYSTEM

PIN # 4715-44-5316

APPLICANT: Chris Bewer APPLICANT ADDRESS: 737 Dula Loop Taylorsville, NC 28681

SITE ADDRESS: Loray Lane PHONE: 828-448-5316 ALT. PHONE:


SITE DIRECTIONS: Island Ford Road, (R) on Woodbridge Rd (L) on Loray Lane on (R) before 128 Loray

SUBDIVISION: n/a SECTION: n/a LOT # ~~N/A~~ 2 LOT AREA: 1.56 DESIGN FLOW: 480 L.T.A.R.: .3

Septic Tank	100 (gal)	STB	160	Date	4-16-13	☒ New System	☐ Repair	☐ Expansion	System Type: I II (III) IV V VI	☒ Residence	No. Bedrooms 4	Water Supply
Pump Tank	(gal)	PT		Date		System Description:	25% Reduction - Gravity			☐ Business	No. Persons	☐ Private
Pump Make		Model		Serial #		Repair System Description:	25% Reduction - ~~Gravity~~ Pump			☐ Other	No. Employees	☒ Public
# Nitrification Fields	1	# Lines	1600	Linear Ft:	400	Maintenance Agreement Required:	☐ YES	☒ NO		☐ Slab	☒ Crawl Space	☐ Community
Trench Width	36"	Max. Trench Bottom Depth	36"	Gravel Depth	n/a		☒ GRAVITY	☐ PRESSURE		☐ Basement w/plumbing	☐ Basement w/o plumbing	

Comments / Conditions:

INITIAL SITE SKETCH

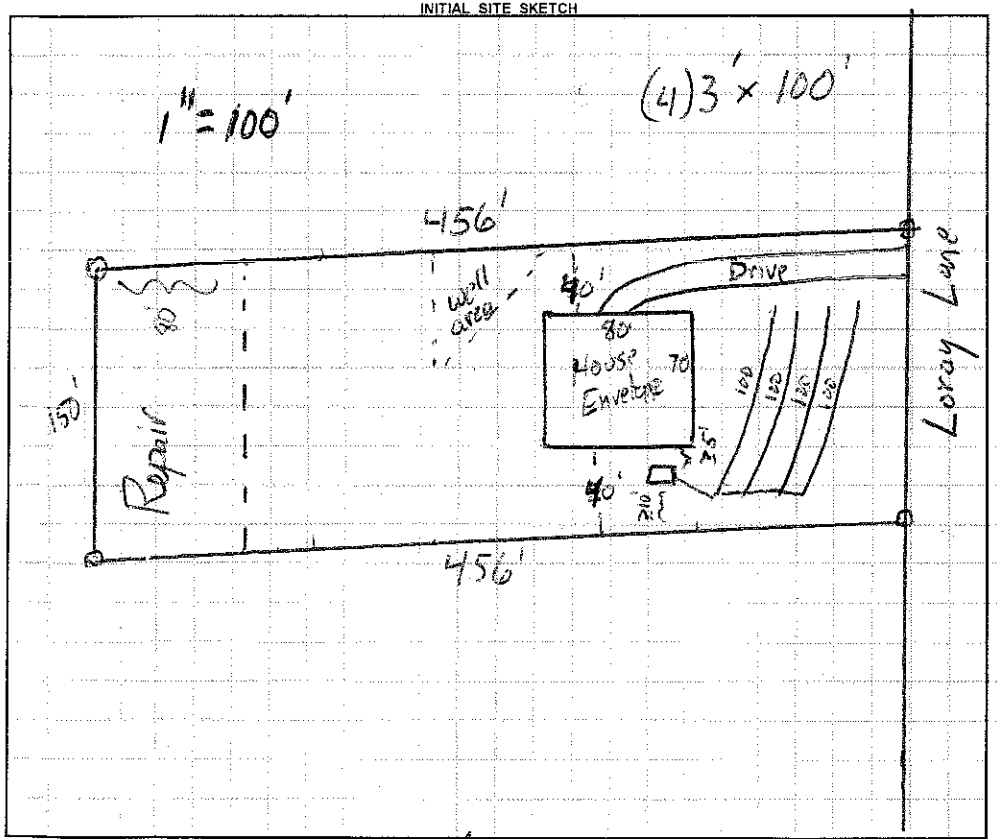

AS BUILT SKETCH

- Red Polylok filter installed
- 2" PVC septic tank marker installed
- Quick 4 Chambers installed
- Installed as drawn

Permit can be suspended or revoked if any false information is supplied toward securing the permit / any unauthorized changes are made to the site / any unauthorized changes are made in the installation of the system. **CONTACT A LOCATOR SERVICE PRIOR TO ANY EXCAVATION**

☐ **IMPROVEMENT PERMIT** ***with plat*** *valid without expiration.* ☒ **IMPROVEMENT PERMIT** ***with site plan*** *valid for 60 mos.* ☒ **AUTHORIZATION TO CONSTRUCT** *valid for period equal to IMPROVEMENT PERMIT--not to exceed 60 mo.*

Owner / Applicant Signature: Chris Bewer Date: 2/27/13 Installed by: Jarrett Grading & Hauling

IMPROVEMENT PERMIT by: James Date: 2-27-13 OPERATION PERMIT by: Justin Middleton Date: 6-20-13

AUTHORIZATION TO CONSTRUCT by: James Date: 2-27-13 Existing System Inspected by: Date:

Health Dept. Copy - WHITE Applicant (Final Approval) - YELLOW Applicant (Conditional Approval) - PINK