IREDELL COUNTY HEALTH DEPARTMENT

STATESVILLE 704-878-5305 (ad) (2) MOORESVILLE 704-664-5281

IMPROVEMENT PERMIT / AUTHORIZATION TO CONSTRUCT / OPERATION PERMIT / EXISTING SYSTEM INSPECTION

PERMIT # 159513 PIN # 4715473887 DATE 6-21-10

OWNER or APPLICANT Robin Benfield PHONE: Business 704 437-6315 Home:

OWNER or APPLICANT ADDRESS 2218 E. Lincoln St. Bloomington, IL 61701

LOCATION / DIRECTIONS 114 Old Loray Lane

SUBDIVISION n/a BLOCK / SECTION n/a LOT # n/a LOT AREA .318 DESIGN FLOW 240 L.T.A.R. .3

Septic Tank 1000 Gallons: STB 760 Date 5-6-10

Pump Tank ____ Gallons: P T ____ Date ____

Pump Make ____ Model ____ Serial # ____

Nitrification Field No Fields 1 No Lines 2 Linear Feet 200

Trench Width 36" Max. Trench Bottom Depth 36" Gravel Depth n/a

☒ New System ☐ Repair ☐ Expansion System Type I II III IV V VI

System Description: 25% Reduction Gravity

Repair System Description: 25% Reduction

Maintenance Agreement Required ☐ YES ☒ NO

☒ GRAVITY ☐ PRESSURE

☒ Residence No. Bedrooms 2 ☐ Business No. Persons ____ ☐ Other No. Employees ____


☐ Slab ☒ Crawl Space ☐ Basement w/plumbing ☐ Basement w/o plumbing

Water Supply: ☐ Private ☒ Public ☐ Community


Comments / Conditions

Comments / Conditions

INITIAL SITE SKETCH

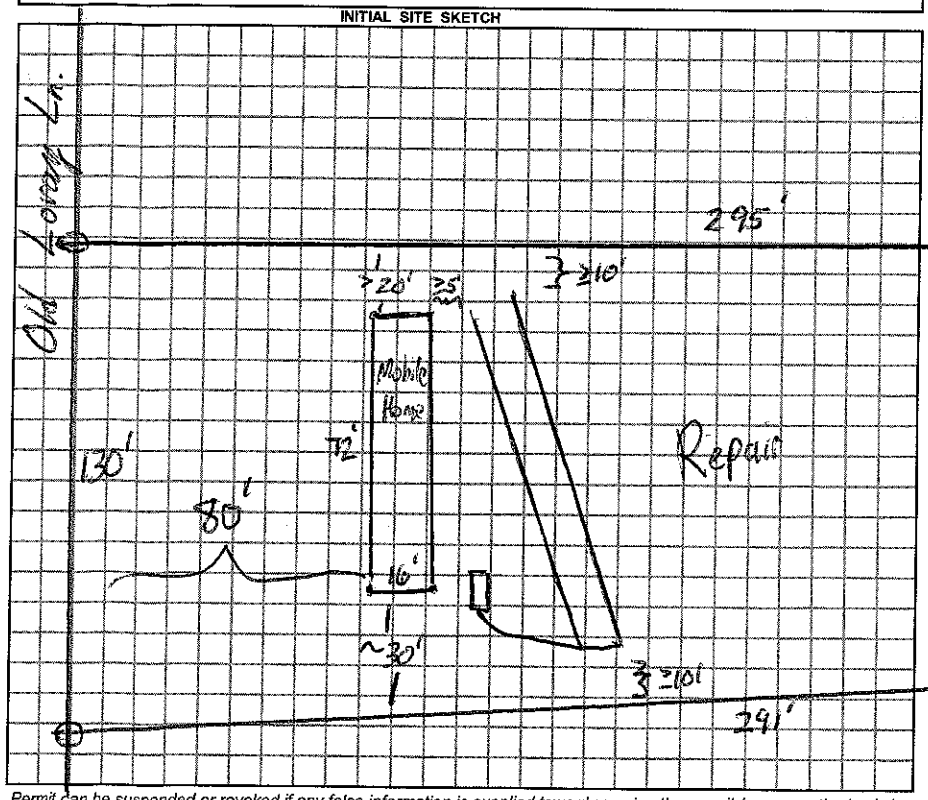

AS BUILT SKETCH

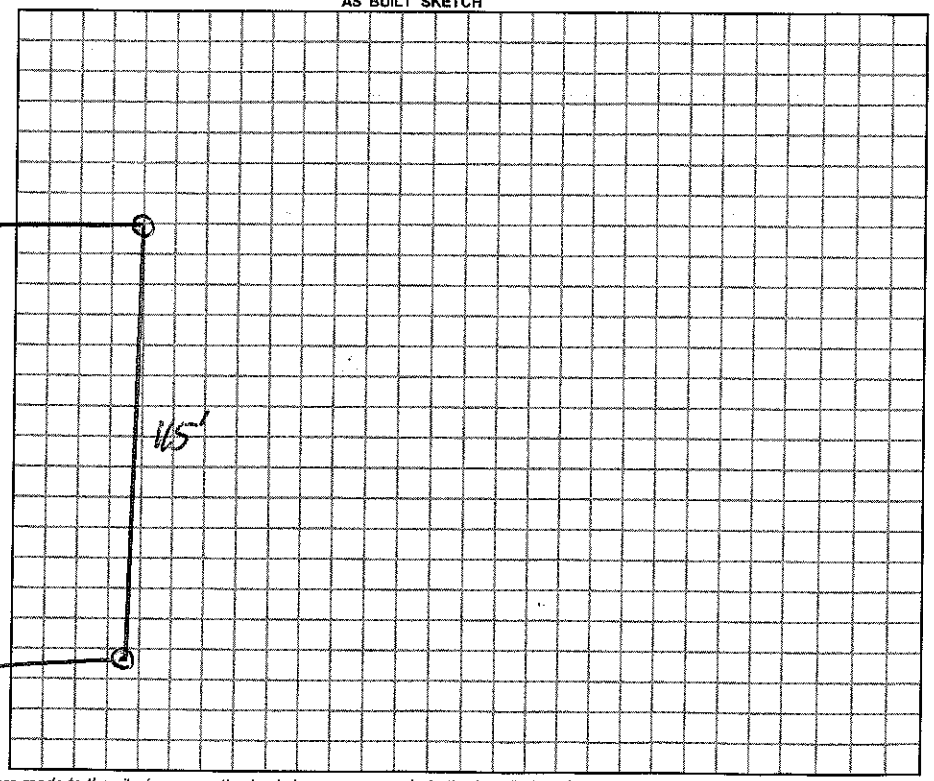

Permit can be suspended or revoked if any false information is supplied toward securing the permit / any unauthorized changes are made to the site / any unauthorized changes are made in the installation of the system.

☐ *IMPROVEMENT PERMIT w / plat valid without expiration.* ☒ *IMPROVEMENT PERMIT w / site plan valid for 60 mos.* ☐ *AUTHORIZATION TO CONSTRUCT valid for period equal to IMPROVEMENT PERMIT-not to exceed 60 mo.*

Owner / Applicant Signature Robin Benfield / Terry Pierce Date 6-22-10

Improvement Permit by: [signature] Date 6-21-10

Authorization to Construct by: [signature] Date 6-22-10

Installed by: Master Clean

Operation Permit by: [signature] Date: 9-17-10

Existing System Inspected by: ____ Date: ____

YOU SHOULD CONTACT A LOCATOR SERVICE PRIOR TO ANY EXCAVATION.

WHITE COPY Environmental Health YELLOW COPY (Final) Owner / Applicant PINK COPY (Initial) Owner / Applicant