IREDELL COUNTY HEALTH DEPARTMENT

STATESVILLE 704-878-5305 MOORESVILLE 704-664-5281

IMPROVEMENT PERMIT / AUTHORIZATION TO CONSTRUCT / OPERATION PERMIT / EXISTING SYSTEM INSPECTION

PERMIT# 09216 PIN# 4715 47 8697 DATE 8/11/00

OWNER OR CONTRACTOR Terry Wingler PHONE: Business _____ Home (704) 872-8209

ADDRESS 111 Tobitha Dr. Statesville NC 28625

LOCATION Hwy 90, L old Loray Ln, on Lt

SUBDIVISION — BLOCK / SECTION — LOT — LOT AREA 1.39 Ac SITE CLASS. PS DESIGN FLOW 360 L.T.A.R. 0.5

Septic Tank: 1000 Gallons; STB 1012 Date 6-11-00
Pump Tank: _____ Gallons; PT _____ Date _____
Pump Make: _____ Model _____ Serial No. _____
Nitrification Field: No Fields 1 Square Feet 1200 Linear Feet 400
No Lines 4 @ 100' Trench Width 36" Max Trench Bottom Depth 24" Gravel Depth 12"

☒ New System ☐ Repair System Type: I (II) III, IV, V, VI
System Description: Gravity Conventional
Repair System Description: Same
Maintenance Agreement Required: ☐ Yes ☒ No

☐ House/Mod. Home No. Bedrooms 5
☒ Mobile Home No. Bathrooms 2½
☐ Business No. Employees ____
☐ Other _____


☐ Slab ☒ Crawl Space ☐ Basement w/plumbing ☐ Basement wo/plumbing

Water Supply: ☐ Individual ☒ Public ☐ Community


Comments/Conditions:

Comments/Conditions
Installed as shown

INITIAL SITE SKETCH

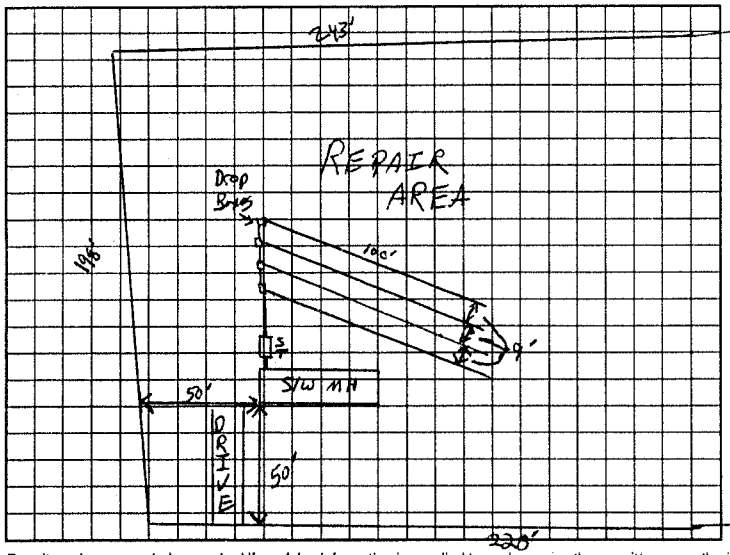

AS BUILT SKETCH

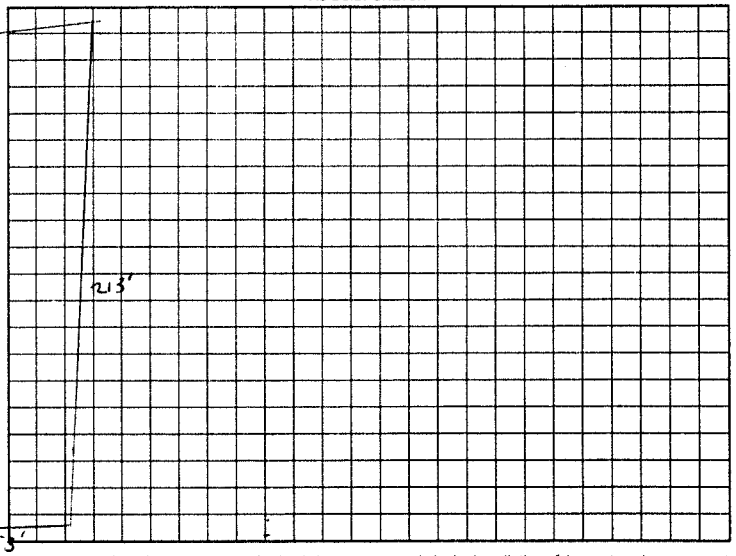

Permit can be suspended or revoked if any false information is supplied toward securing the permit/any unauthorized changes are made to the site/any unauthorized changes are made in the installation of the system. Improvement Permit with plat valid without expiration. Improvement Permit with site plan valid for sixty months. Authorization to Construct is valid for a period equal to that of Improvement Permit – not to exceed sixty months.

Signed: Terry Wingler date 8/11/00 Installed by: Dale Wingler

Improvement Permit by: Craig McAuley LSI date 8/11/00 Operation Permit by: Mark Ostby HD date 8-22-00

Authorization to Construct by: Craig McAuley LSI date 8/11/00 Existing System Inspection by: _____ date _____

HEALTH DEPT. COPY: WHITE OWNER COPY (FINAL): YELLOW OWNER COPY (INITIAL): PINK