000788

IREDELL COUNTY HEALTH DEPARTMENT

STATESVILLE 704-878-5305 MOORESVILLE 704-664-5281

IMPROVEMENT PERMIT / CERTIFICATE OF COMPLETION / OPERATION PERMIT / EXISTING SYSTEM INSPECTION

PROPERTY DESCRIPTION NO. REPAIR DATE 2/20/95 TAX MAP NO. Watershed: ☐ Yes ~~☐ No~~

OWNER OR CONTRACTOR IREDELL COUNTY (GARAGE) PHONE: Business Home 873-8063

ADDRESS 186 STEVENSON FARM ROAD STATESVILLE NC 28677

LOCATION NC 90 W, TR LITTLE FARM RD, TL STEVENSON FARM RD, ON RIGHT AT PAVEMENT END

SUBDIVISION BLOCK / SECTION LOT LOT AREA SITE CLASS PS DESIGN FLOW 200 L.T.A.R. 0.3 GPD/FT²

Septic Tank: 1000 Gallons; STB 620 Date 4/25/94

Pump Tank: Gallons; PT Date

Pump Make: Model Serial No.

Nitrification Field: No Fields 1 Square Feet 690 Linear Feet 230

No Lines 2 Trench Width 36" Max Trench Bottom Depth 18-36" Gravel Depth 12"

☐ New System ☒ Repair System Type: I, II, IV, V, VI

System Description: CONVENTIONAL GRAVITY

Repair System Description: CONV. GRAVITY

Maintenance Agreement Required: ☐ Yes ~~☐ No~~

☐ House/Mod. Home No. Bedrooms

☐ Mobile Home No Bathrooms

☒ Business No. Employees 3

☐ Other SIZED AT 200 GPD


☒ Slab ☐ Crawl Space ☐ Basement w/plumbing ☐ Basement wo/plumbing

Water Supply: ☐ Individual ☐ Community ☒ Public


Comments: ① EXCAVATE & REMOVE EXISTING DRUM TANK AND REPLACE WITH 1000 GAL S.T. AS SHOWN ② INSTALL 3" SCH 40 PVC PIPE AS SHOWN, MINIMUM 30" DEEP UNDER AREAS SUBJECT TO VEHICULAR TRAFFIC.

Comments: SYSTEM INSTALLED ACCORDING TO INITAL SITE SKETCH

INITIAL SITE SKETCH

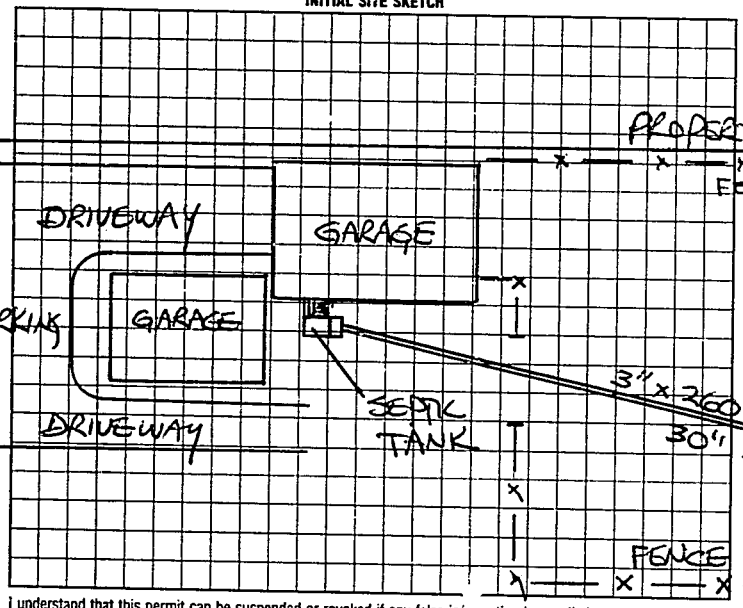

AS BUILT SKETCH

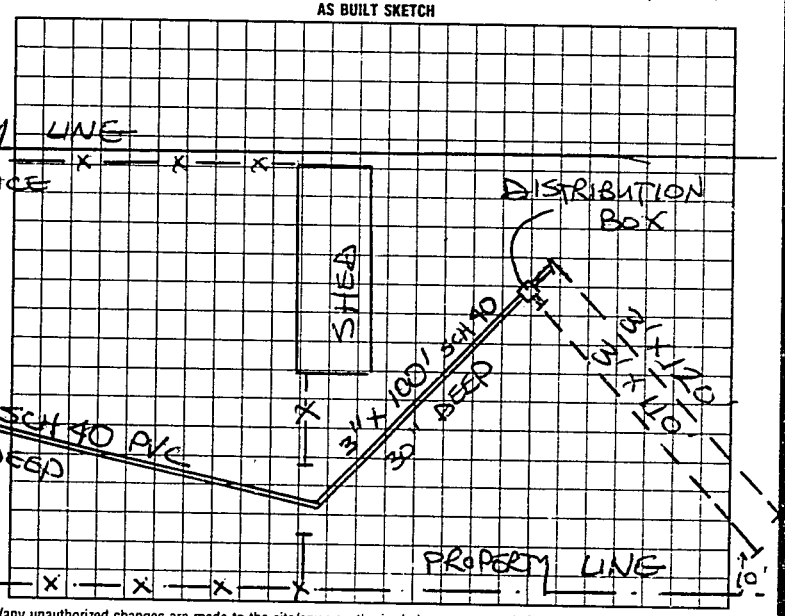

I understand that this permit can be suspended or revoked if any false information is supplied toward securing the permit/any unauthorized changes are made to the site/any unauthorized changes are made in the installation of the system. Improvement Permit is valid for 60 months from date of issuance.

Signed:

Improvement Permit by: STEVE HEDRICK, RS date 2/20/95

Existing System Inspection by: date

Installed by: TOMMY NIXON

Certificate of Completion by: STEVE HEDRICK date 4/28/95

Operation Permit by: date

HEALTH DEPT. COPY: WHITE INSPECTION COPY (FINAL): GREEN OWNER COPY (FINAL): YELLOW INSPECTION COPY (INITIAL): PINK OWNER COPY (INITIAL): GOLD