THIS PERMIT VOIDS PREVIOUS ISSUED 6-13-2000

IREDELL COUNTY HEALTH DEPARTMENT

STATESVILLE 704-878-5305 MOORESVILLE 704-664-5281

IMPROVEMENT PERMIT / AUTHORIZATION TO CONSTRUCT / OPERATION PERMIT / EXISTING SYSTEM INSPECTION

PERMIT# 089683 PIN# 4715 51 03601 DATE 9-28-00

OWNER OR CONTRACTOR RICKY CARNEY PHONE: Business Home 872-4831

ADDRESS 260 CANNON ROAD, STATESVILLE, NC 28625

LOCATION IREDELL FORD ROAD, TR CANNON ROAD, ON RIGHT AT BOX #260, BACK OFF ROAD 600'

SUBDIVISION BLOCK / SECTION LOT LOT AREA AMPLE SITE CLASS PS DESIGN FLOW 600 L.T.A.R. 0.40 GPD/FT²

Septic Tank: 1000 Gallons; STB 1012 Date 8-15-00
Pump Tank: Gallons; PT Date
Pump Make: Model Serial No.
Nitrification Field: No Fields 1 Square Feet 1500 Linear Feet 500
No Lines FOUR Trench Width 36" Max Trench Bottom Depth 36" Gravel Depth 12"

☑ New System ☐ Repair System Type: I II III IV V VI
System Description: CONVENTIONAL SPANN
Repair System Description: CONVENTIONAL SPANN
Maintenance Agreement Required: ☐ Yes ☑ No

☑ House/Mod Home No. Bedrooms 4
☐ Mobile Home No. Bathrooms 3
☐ Business No. Employees
☐ Other W/ OFFICE


☑ Slab ☐ Crawl Space ☐ Basement w/plumbing ☐ Basement wo/plumbing

Water Supply: ☑ Individual ☐ Public ☐ Community WELL

Comments/Conditions:

Comments/Conditions: SEPTIC TANK WITH RISERS INSTALLED USING "POLY LOK" FILTER

INITIAL SITE SKETCH

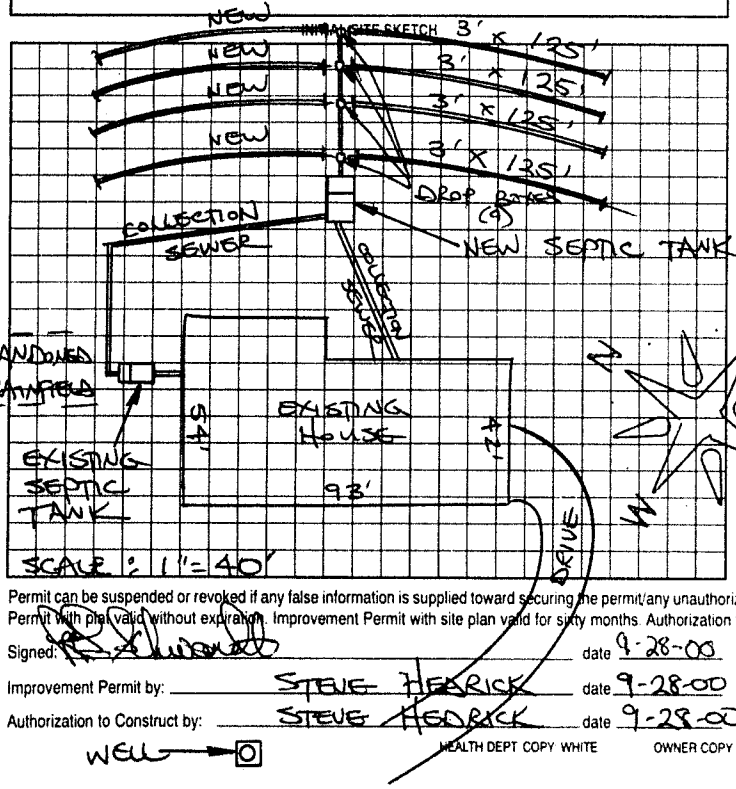

AS BUILT SKETCH

SYSTEM INSTALLED ACCORDING TO INITAL SITE SKETCH

Permit can be suspended or revoked if any false information is supplied toward securing the permit/any unauthorized changes are made to the site/any unauthorized changes are made in the installation of the system. Improvement Permit with plat valid without expiration. Improvement Permit with site plan valid for sixty months. Authorization to Construct is valid for a period equal to that of Improvement Permit - not to exceed sixty months.

Signed: [signature] date 9-28-00 Installed by: BOB SCHWABIN

Improvement Permit by: STEVE HEDRICK date 9-28-00 Operation Permit by: STEVE HEDRICK date 4-24-01

Authorization to Construct by: STEVE HEDRICK date 9-28-00 Existing System Inspection by: date

WELL → ⊡

HEALTH DEPT COPY WHITE OWNER COPY (FINAL) YELLOW OWNER COPY (INITIAL) PINK