IREDELL COUNTY HEALTH DEPARTMENT

Statesville Office (704) 878-5305 Mooresville Office (704) 660-3625 PERMIT # 230-300 178266

IMPROVEMENT PERMIT / AUTHORIZATION TO CONSTRUCT / OPERATION PERMIT / EXISTING SYSTEM

PIN # 4715530293

APPLICANT: PMA Investments APPLICANT ADDRESS: P.O. Box 5475 Statesville, NC 28687

SITE ADDRESS: 186 Draper Drive PHONE: 704-658-5514 ALT. PHONE:


SITE DIRECTIONS: 40W, (R) onto 64W, (L) onto Woodbridge, (L) Russell Ridge, (R) Draper Lot on (L) (R)

SUBDIVISION: Wood Bridge Estates SECTION: 2 LOT # 20 LOT AREA: .760 DESIGN FLOW: 480 L.T.A.R.: .3

Septic Tank 1000 (gal)	STB 825	Date 8/22/13	☒ New System ☐ Repair ☐ Expansion	System Type: I II (III) IV V VI	☒ Residence	No. Bedrooms 4	Water Supply
Pump Tank (gal)	PT	Date	System Description: 25% Reduction Gravity		☐ Business	No. Persons	☐ Private
Pump Make	Model	Serial #	Repair System Description: 25% Reduction Pump		☐ Other	No. Employees	☒ Public
# Nitrification Fields 1	# Lines 6	Linear Ft: 400 total	Maintenance Agreement Required: ☐ YES ☒ NO		☐ Slab	☒ Crawl Space	☐ Community
Trench Width 36"	Max. Trench Bottom Depth 36	Gravel Depth n/a	☒ GRAVITY ☐ PRESSURE		☐ Basement w/plumbing	☐ Basement w/o plumbing	

Comments / Conditions:

INITIAL SITE SKETCH

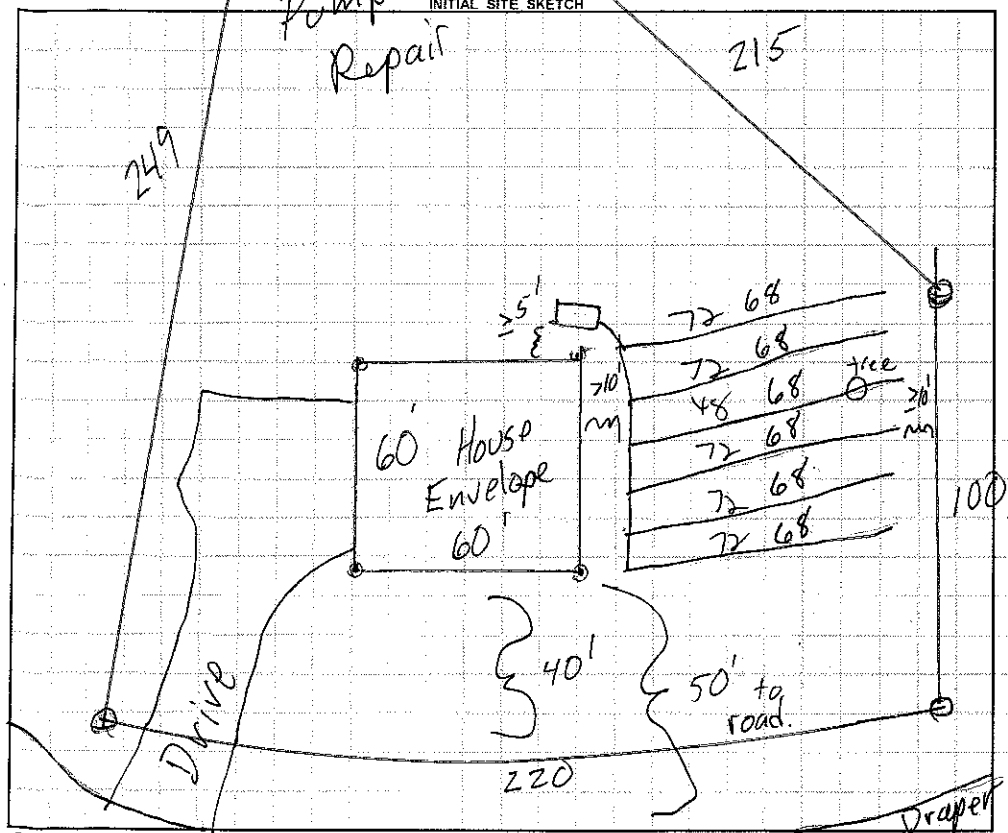

AS BUILT SKETCH

Permit can be suspended or revoked if any false information is supplied toward securing the permit / any unauthorized changes are made to the site / any unauthorized changes are made in the installation of the system. **CONTACT A LOCATOR SERVICE PRIOR TO ANY EXCAVATION**

☐ **IMPROVEMENT PERMIT** ***with plat*** *valid without expiration.* ☐ **IMPROVEMENT PERMIT** ***with site plan*** *valid for 60 mos.* ☐ **AUTHORIZATION TO CONSTRUCT** *valid for period equal to IMPROVEMENT PERMIT--not to exceed 60 mo.*

Owner / Applicant Signature: Valerie Steven Date: 5-28-13 Installed by: Rowan Septic

IMPROVEMENT PERMIT by: [signature] Date: 5-22-13 OPERATION PERMIT by: [signature] Date: 10/10/13

AUTHORIZATION TO CONSTRUCT by: [signature] Date: 5-22-13 Existing System Inspected by: Date:

Health Dept. Copy - WHITE Applicant (Final Approval) - YELLOW Applicant (Conditional Approval) - PINK