Marc Kurth

IREDELL COUNTY HEALTH DEPARTMENT

STATESVILLE 704-878-5305 MOORESVILLE 704-664-5281

IMPROVEMENT PERMIT / AUTHORIZATION TO CONSTRUCT / OPERATION PERMIT / EXISTING SYSTEM INSPECTION

PERMIT # 15620 PIN # 4715534457

OWNER or APPLICANT C & D Excavating (PMA) DATE 5-25-09

OWNER or APPLICANT ADDRESS 118 Sams Trail Lane Statesville NC 28625 PHONE: Business Home: 704-872-7855

LOCATION / DIRECTIONS 64W (L) Wood Bridge (L) Russell (R) Draper on right

SUBDIVISION Woodbridge BLOCK / SECTION LOT # 18 LOT AREA 1.272 DESIGN FLOW 480 L.T.A.R. .3

Septic Tank 1000 Gallons: STB 825 Date 6-11-09

Pump Tank Gallons: PT Date

Pump Make Model Serial #

Nitrification Field No Fields No Lines 3 Linear Feet 430

Trench Width 36" Max. Trench Bottom Depth 36" Gravel Depth NA

☑ New System ☐ Repair ☐ Expansion System Type I II III IV V VI

System Description: 25% Gravity

Repair System Description: 25% Pump

Maintenance Agreement Required ☐ YES ☑ NO

☑ GRAVITY ☐ PRESSURE

☑ Residence No. Bedrooms 4

☐ Business No. Persons

☐ Other No. Employees

☐ Slab ☑ Crawl Space


☐ Basement w/plumbing ☐ Basement w/o plumbing

Water Supply ☐ Private ☑ Public ☐ Community


Comments / Conditions

Comments / Conditions Install on Contour. Maintain all setbacks

INITIAL SITE SKETCH

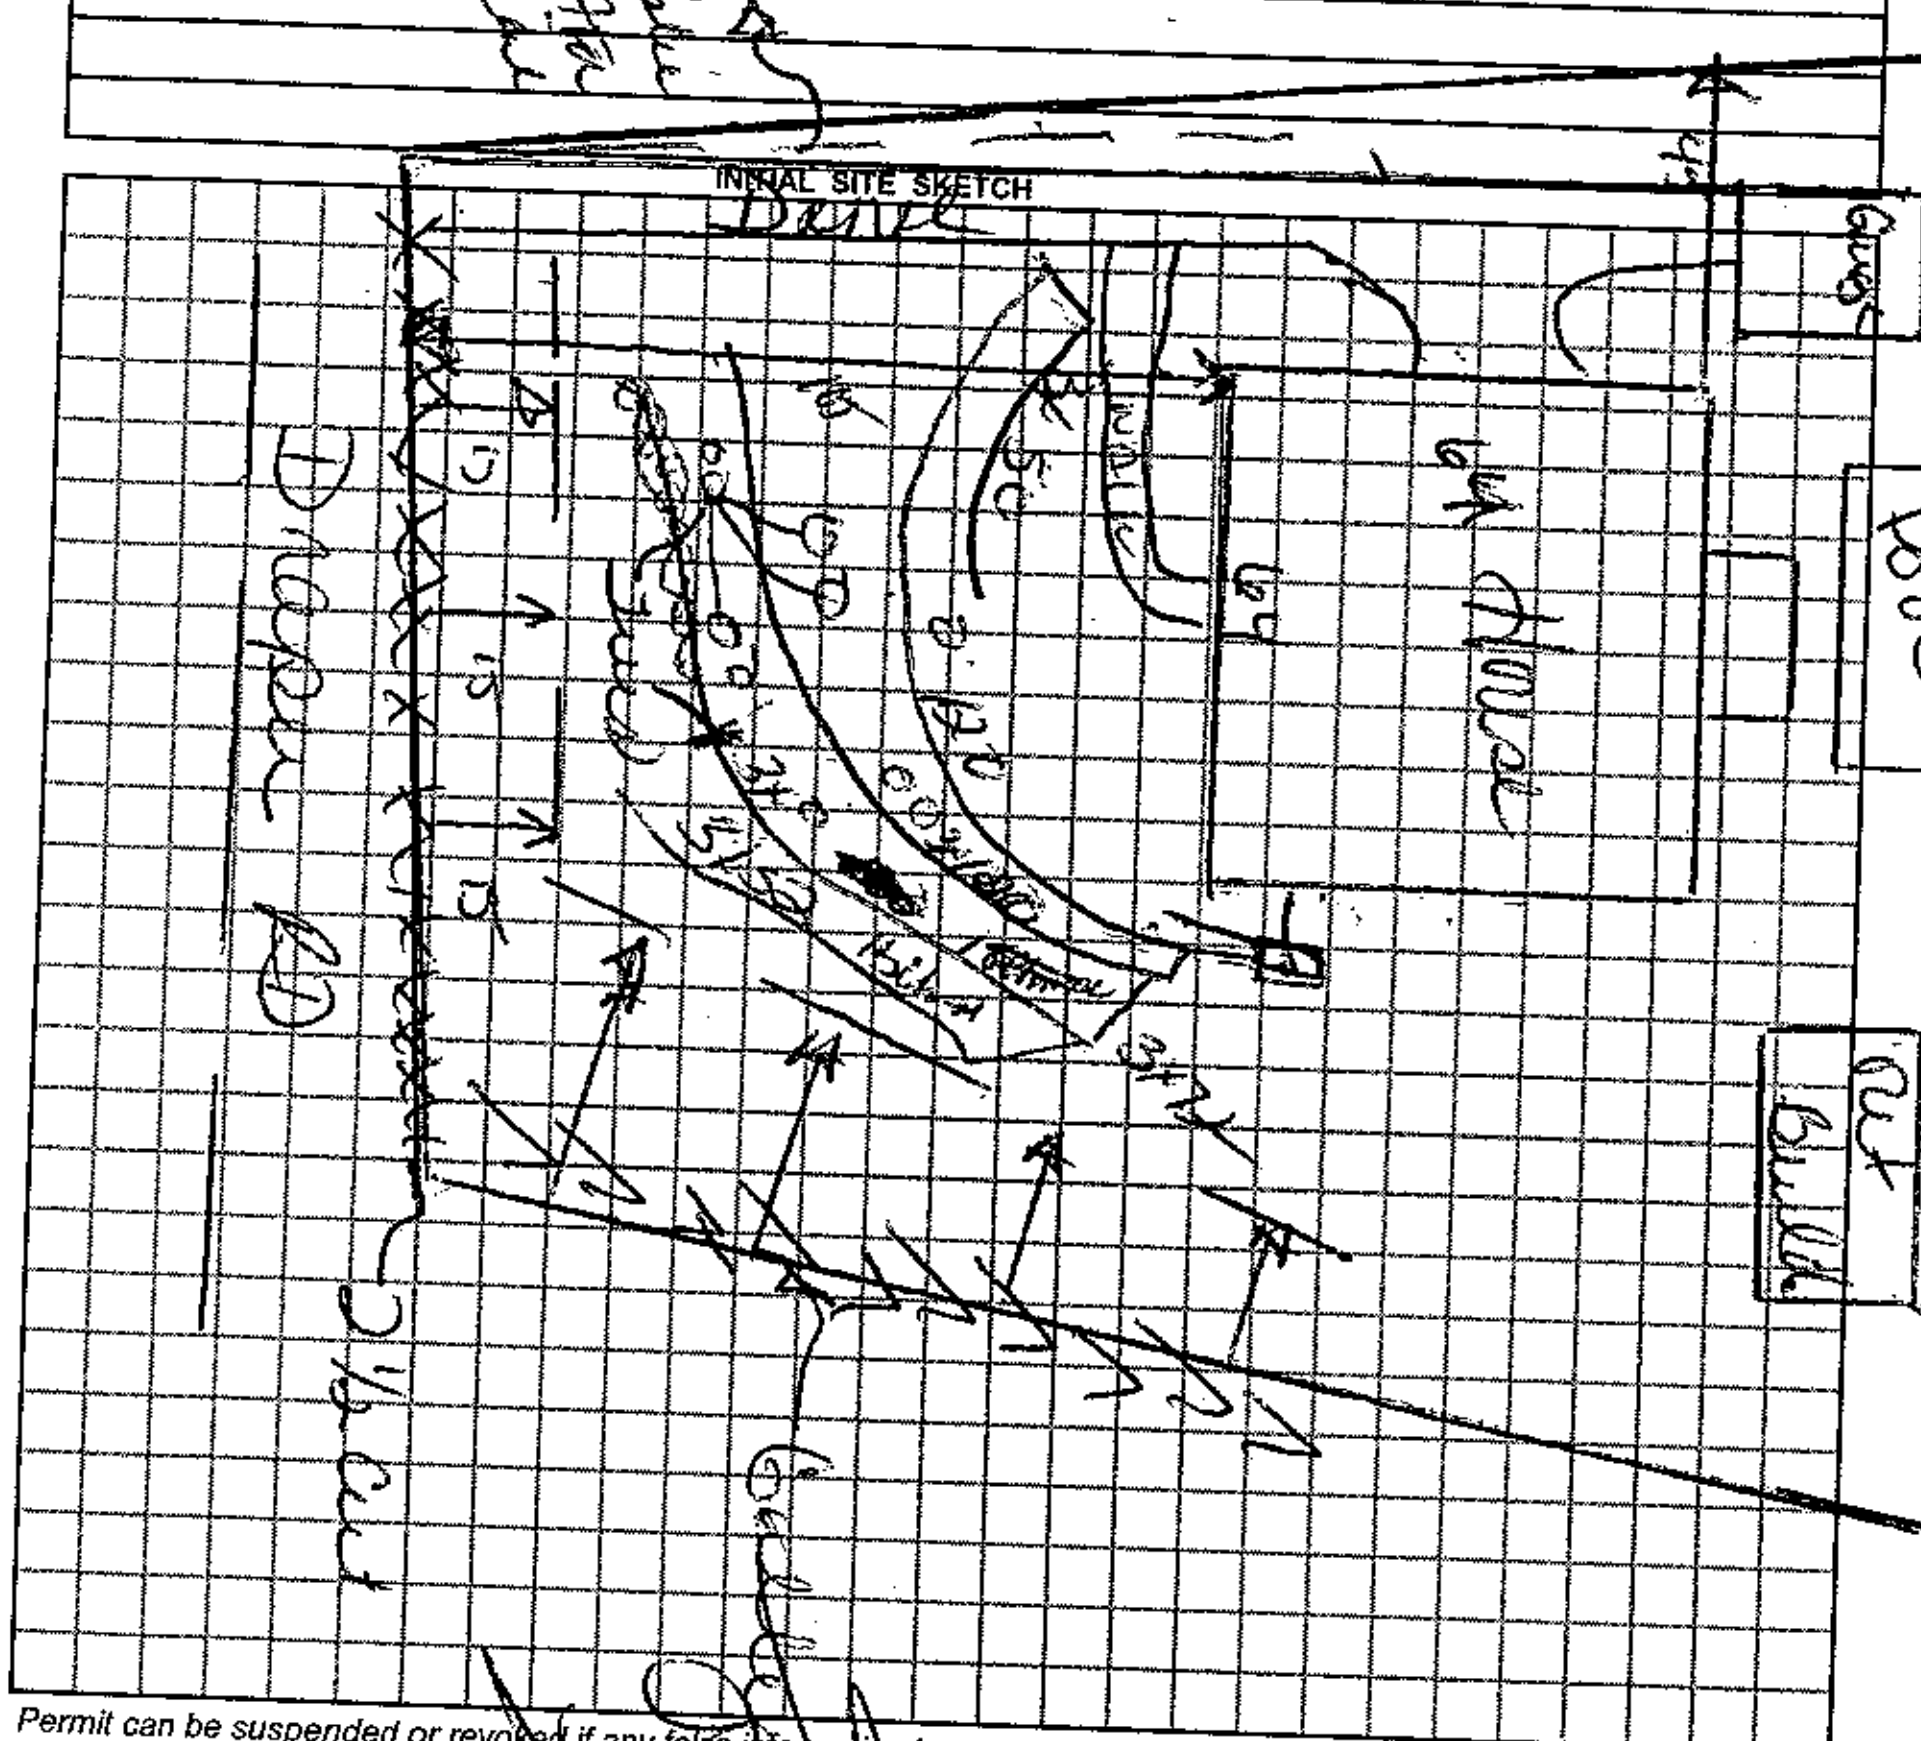

AS BUILT SKETCH

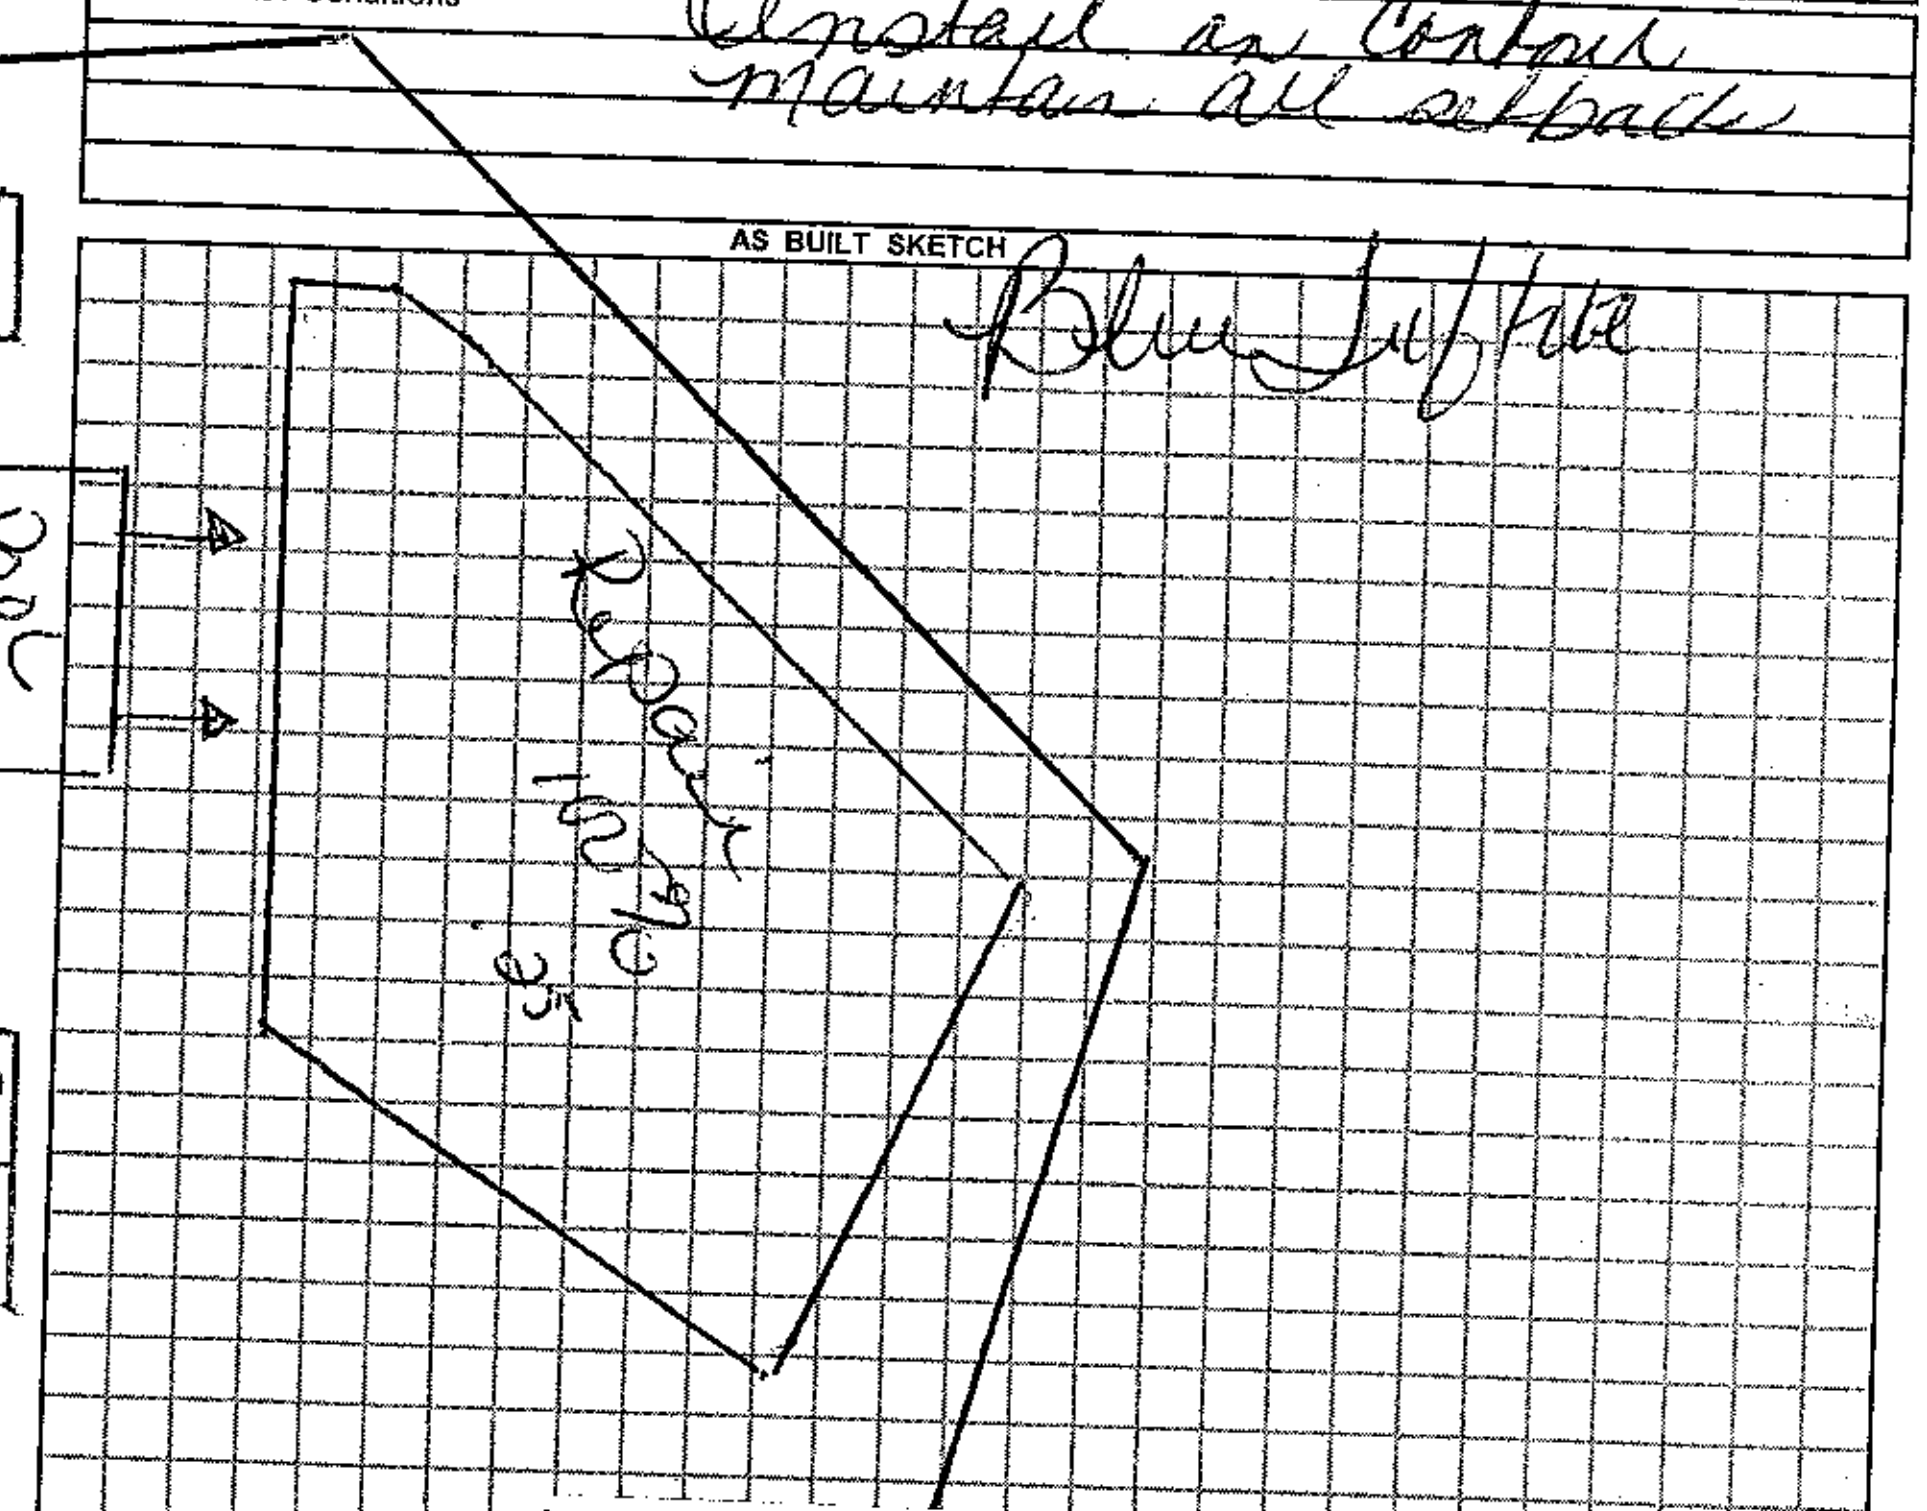

Location of the proposed Pool addition does not appear to impact the existing on-site septic system.**NOTE:

REHS

Date: 8-6-12

ICHD-Environmental Health Division

Permit can be suspended or revoked if any false information is supplied toward securing the permit / any unauthorized changes are made to the site / any unauthorized

☐ IMPROVEMENT PERMIT w / plat valid without expiration ☐ IMPROVEMENT PERMIT w / site plan valid for 60 mos. ☑ AUTHORIZATION TO

Owner / Applicant Signature: Date 5-25-09

Improvement Permit by: Date 5-25-09

Authorzation to Construct by: Date 5-25-09

YOU SHOULD CONTACT A LOCATOR SERVICE PRIOR TO ANY EXCAVATION.

Installed by: Rowan Septic

Operation Permit by: Date: 8-25-09

Existing System Inspected by: Date:

WHITE COPY Environmental Health YELLOW COPY (Final) Owner / Applicant PINK COPY (Initial) Owner / Applicant