IREDELL COUNTY HEALTH DEPARTMENT

Statesville Office (704) 878-5305 Mooresville Office (704) 660-3625 PERMIT # 21389

IMPROVEMENT PERMIT / AUTHORIZATION TO CONSTRUCT / OPERATION PERMIT / EXISTING SYSTEM

PIN # 4715538553

APPLICANT: PMA Investments LLC APPLICANT ADDRESS: Po Box 5474 Statesville

SITE ADDRESS: 149 Draper Dr. PHONE: 704-658-5514 ALT. PHONE: N/A


SITE DIRECTIONS: Hwy 64 W TL Woodbridge TL Russell Ridge TR Draper Lot on Left

SUBDIVISION: Woodbridge Estates SECTION: P252 LOT # 28 LOT AREA: 0.68 acres DESIGN FLOW: 480gpd L.T.A.R.: 0.3


Septic Tank	1000 (gal)	STB SZS-7001	Date 3-20-16	☑ New System ☐ Repair ☐ Expansion	System Type: I II III IV V VI	☑ Residence	No. Bedrooms	4	Water Supply
Pump Tank	(gal)	PT	Date	System Description:	25% Reduction	☐ Business	No. Persons	5	☐ Private
Pump Make	Model		Serial #	Repair System Description:	TSI DRIP	☐ Other	No. Employees		☑ Public
# Nitrification Fields	1 # Lines 6		Linear Ft: 400	Maintenance Agreement Required:	☐ YES ☑ NO	☐ Slab	☑ Crawl Space		☐ Community
Trench Width	36" Max. Trench Bottom Depth		23" Gravel Depth N/A		☑ GRAVITY ☐ PRESSURE	☐ Basement w/plumbing		☐ Basement w/o plumbing	

Comments / Conditions: Improvements ONLY. Submit floor plan prior to issuance of CA. Install a 25% Reduction system on contour with serial distribution. Max trench bottom depth is 23" on high side.

INITIAL SITE SKETCH

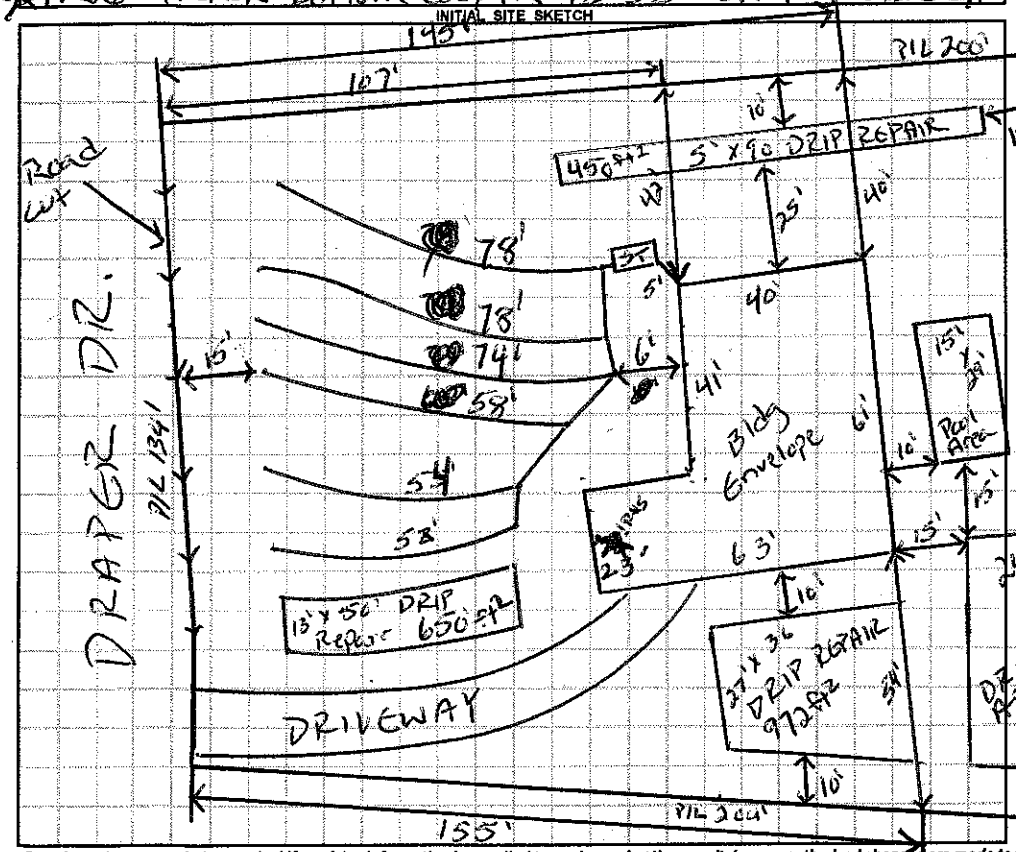

AS BUILT SKETCH

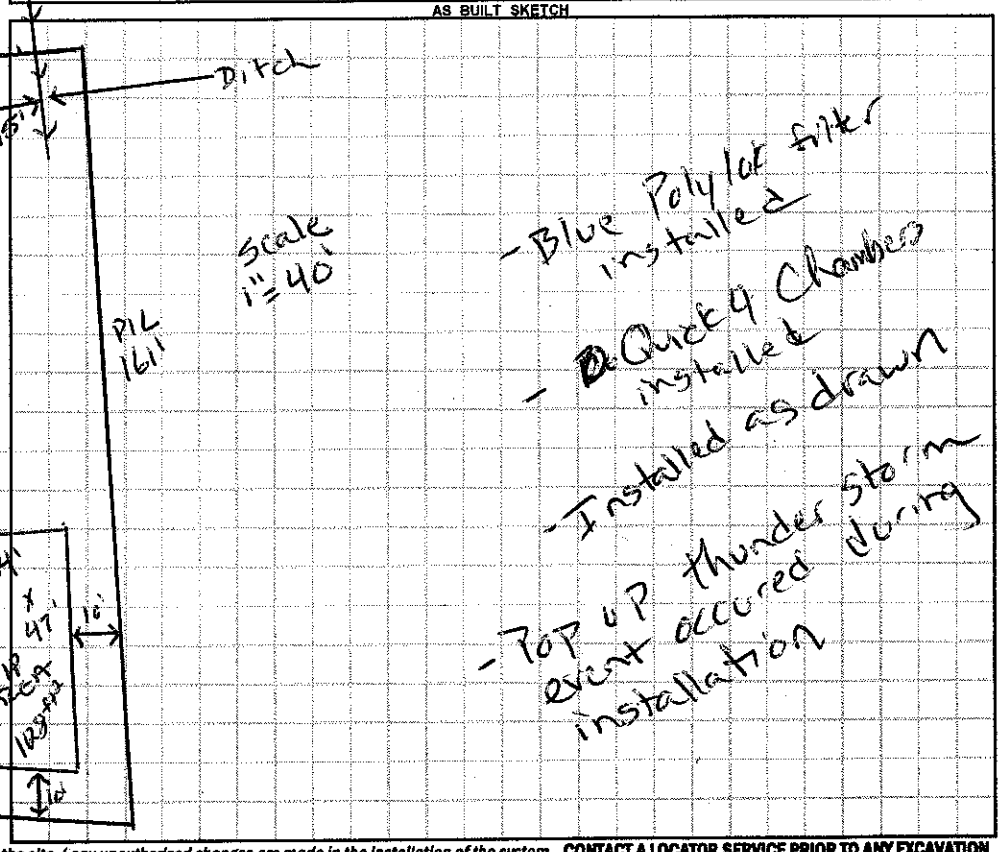

Permit can be suspended or revoked if any false information is supplied toward securing the permit / any unauthorized changes are made to the site / any unauthorized changes are made in the installation of the system. **CONTACT A LOCATOR SERVICE PRIOR TO ANY EXCAVATION**

☐ **IMPROVEMENT PERMIT** *with plat valid without expiration.* ☑ **IMPROVEMENT PERMIT** *with site plan valid for 60 mos.* ☐ **AUTHORIZATION TO CONSTRUCT** *valid for period equal to IMPROVEMENT PERMIT--not to exceed 60 mo.*

Owner / Applicant Signature: Valerie Stevens Date: 10-30-15 Installed by: Rowan Septic

IMPROVEMENT PERMIT by: Justin Henderson Date: 10-30-15 OPERATION PERMIT by: Justin Henderson Date: 6-2-16

AUTHORIZATION TO CONSTRUCT by: Date: 11/3/15 Existing System Inspected by: Date:

Health Dept. Copy - WHITE Applicant (Final Approval) - YELLOW Applicant (Conditional Approval) - PINK