IREDELL COUNTY HEALTH DEPARTMENT

Replaces Permit issued 5-6-08.

STATESVILLE 704-878-5305 MOORESVILLE 704-664-5281

IMPROVEMENT PERMIT / AUTHORIZATION TO CONSTRUCT / OPERATION PERMIT / EXISTING SYSTEM INSPECTION

PERMIT # 149335 PIN # 4715-53-8618 DATE 7 June 10

OWNER or APPLICANT PAMA INVESTMENTS, LLC PHONE: Business (704) 622-1881 Home:

OWNER or APPLICANT ADDRESS 452 Woodbridge Rd. Statesville

LOCATION / DIRECTIONS ~~Hwy~~ Draper Dr.

SUBDIVISION Woodbridge Estates BLOCK / SECTION 2 LOT # 29 LOT AREA 0.668 ac. DESIGN FLOW 480 g/d L.T.A.R. 0.3 g/ft²/d

Septic Tank 1000 Gallons: STB 825 Date 7-28-10

Pump Tank Gallons: P T Date

Pump Make Model Serial #

Nitrification Field No Fields 1 No Lines 6 Linear Feet 400

Trench Width 36" Max. Trench Bottom Depth 36" Gravel Depth NA

☑ New System ☐ Repair ☐ Expansion System Type I II ◯III IV V VI

System Description: 25% Reduction

Repair System Description: 50% Reduction - LPP

Maintenance Agreement Required ☐ YES ☑ NO

☑ GRAVITY ☐ PRESSURE

☑ Residence No. Bedrooms 4

☐ Business No. Persons

☐ Other No. Employees

☐ Slab ☑ Crawl Space


☐ Basement w/plumbing ☐ Basement w/o plumbing

Water Supply: ☐ Private ☑ Public ☐ Community


Comments / Conditions: Follow contour / Keep 15' from front road cut / Honor all setbacks.

Comments / Conditions

INITIAL SITE SKETCH

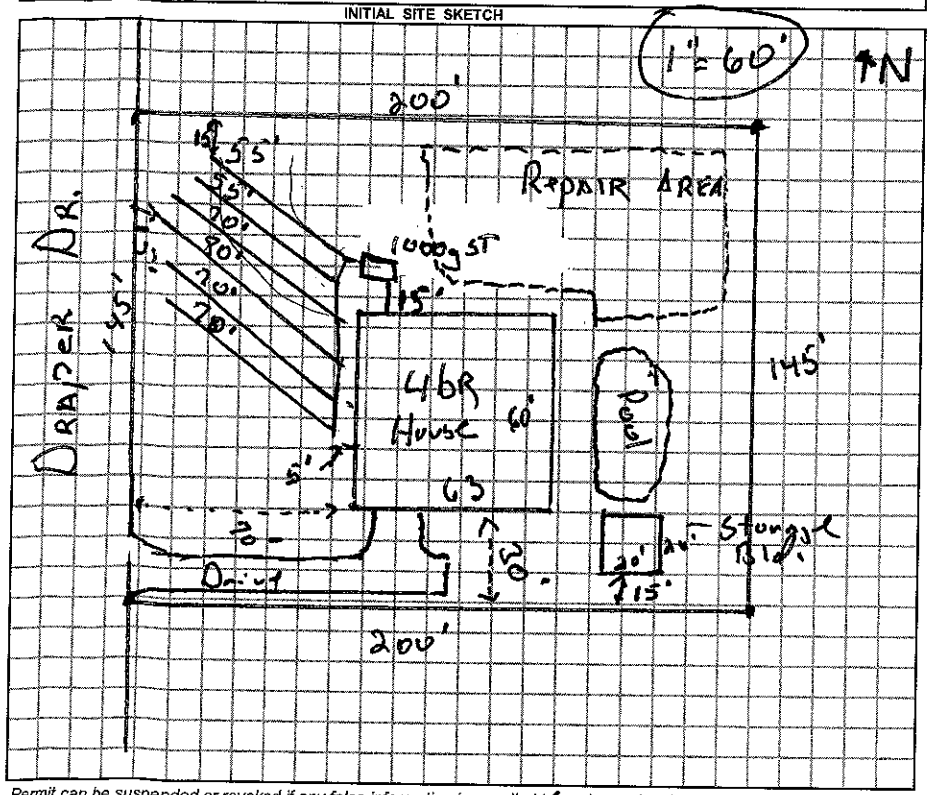

AS BUILT SKETCH

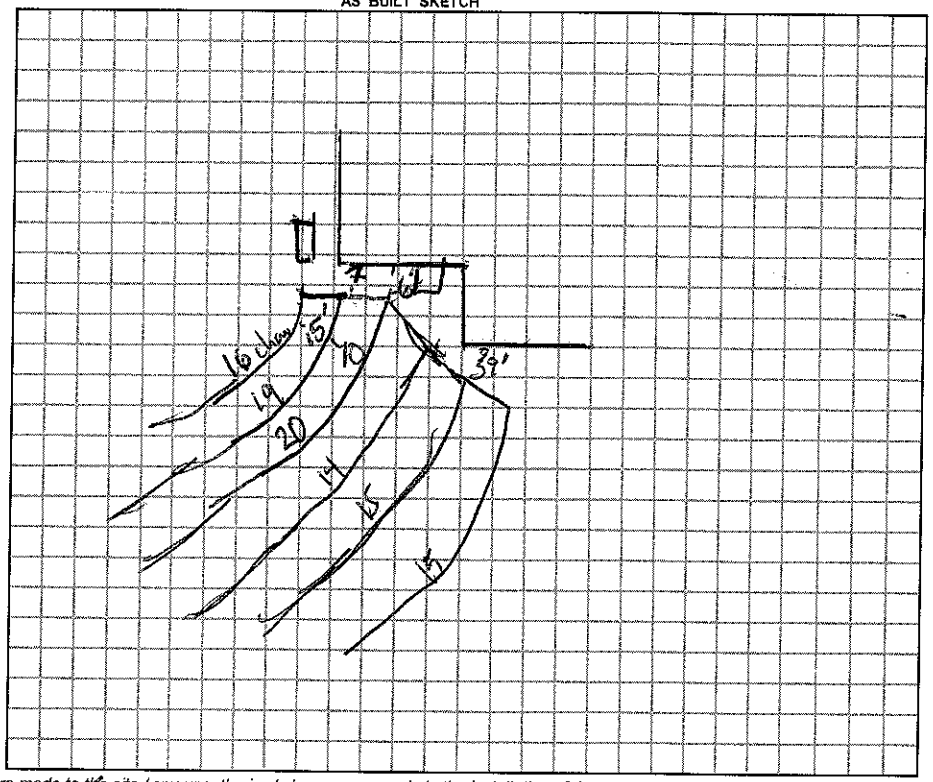

Permit can be suspended or revoked if any false information is supplied toward securing the permit / any unauthorized changes are made to the site / any unauthorized changes are made in the installation of the system.

☐ *IMPROVEMENT PERMIT w / plat valid without expiration.* ☑ *IMPROVEMENT PERMIT w / site plan valid for 60 mos.* ☑ *AUTHORIZATION TO CONSTRUCT valid for period equal to IMPROVEMENT PERMIT-not to exceed 60 mo.*

Owner / Applicant Signature: Date 6-7-10

Improvement Permit by: , R.S. Date 7 June 10

Authorization to Construct by: , R.S. Date 7 June 10

Installed by: Rowan Septic

Operation Permit by: Date: 9-7-10

Existing System Inspected by: Date:

YOU SHOULD CONTACT A LOCATOR SERVICE PRIOR TO ANY EXCAVATION.

WHITE COPY Environmental Health YELLOW COPY (Final) Owner / Applicant PINK COPY (Initial) Owner / Applicant