THIS PERMIT VOIDS PERMIT ISSUED 5/6/8

IREDELL COUNTY HEALTH DEPARTMENT - *ENVIRONMENTAL HEALTH* ☒ STATESVILLE OFFICE 704-878-5305 ☐ MOORESVILLE OFFICE 704-664-5281

IMPROVEMENT PERMIT / AUTHORIZATION TO CONSTRUCT / OPERATION PERMIT / EXISTING SYSTEM INSPECTION

PERMIT # 14933B PIN # 4715538872 DATE 5-30-12

OWNER PMA Investments APPLICANT: PHONE: Home/Cell # 704-902-8735 Business #

SITE ADDRESS 137 Draper Dr. OWNER / APPLICANT ADDRESS 1950 Jaya Dr. Sherrills Ford, NC 28673

SITE DIRECTIONS Hwy 64 W (L) on Woodbridge, (L) on Russell Ridge, ~~1st (L)~~ (R) on Draper, Lot on (L)

SUBDIVISION Woodbridge Estates BLOCK / SECTION LOT # 38 LOT AREA .867 DESIGN FLOW 480 L.T.A.R. .3

Septic Tank 1000 Gallons: STB 825 Date 8-19-12
Pump Tank Gallons: P T Date
Pump Make Model Serial #
No. Nitrification Fields 1 No. Lines 6 Linear Feet 400
Trench Width 36" Max. Trench Bottom Depth 36" Gravel Depth n/a


☒ New System ☐ Repair ☐ Expansion System Type I II (III) IV V VI
System Description: 25% Reduction Gravity
Repair System Description: 50% Reduction LP
Maintenance Agreement Required ☐ YES ☒ NO
☒ GRAVITY ☐ PRESSURE

☒ Residence No. Bedrooms 4
☐ Business No. Persons
☐ Other No. Employees
☐ Slab ☒ Crawl Space
☐ Basement w/plumbing ☐ Basement w/o plumbing


Water Supply: ☐ Private ☒ Public ☐ Community

Comments / Conditions

INITIAL SITE SKETCH

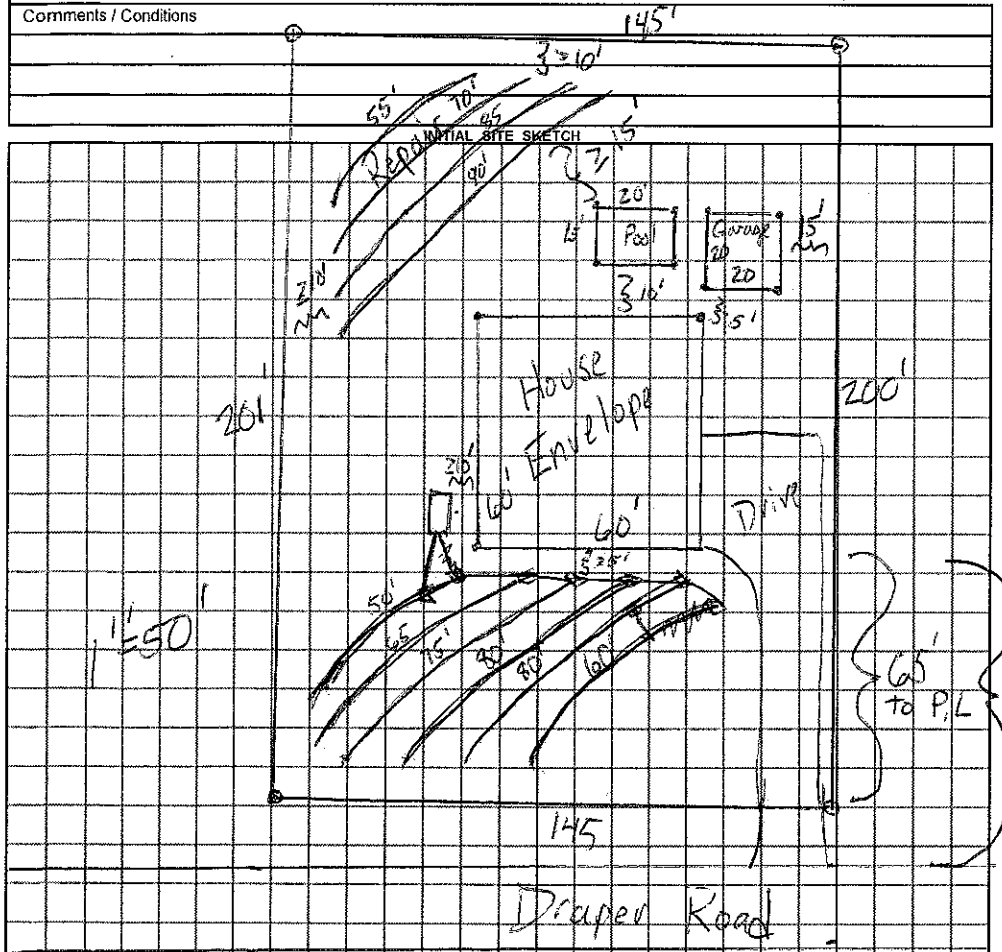

AS BUILT SKETCH

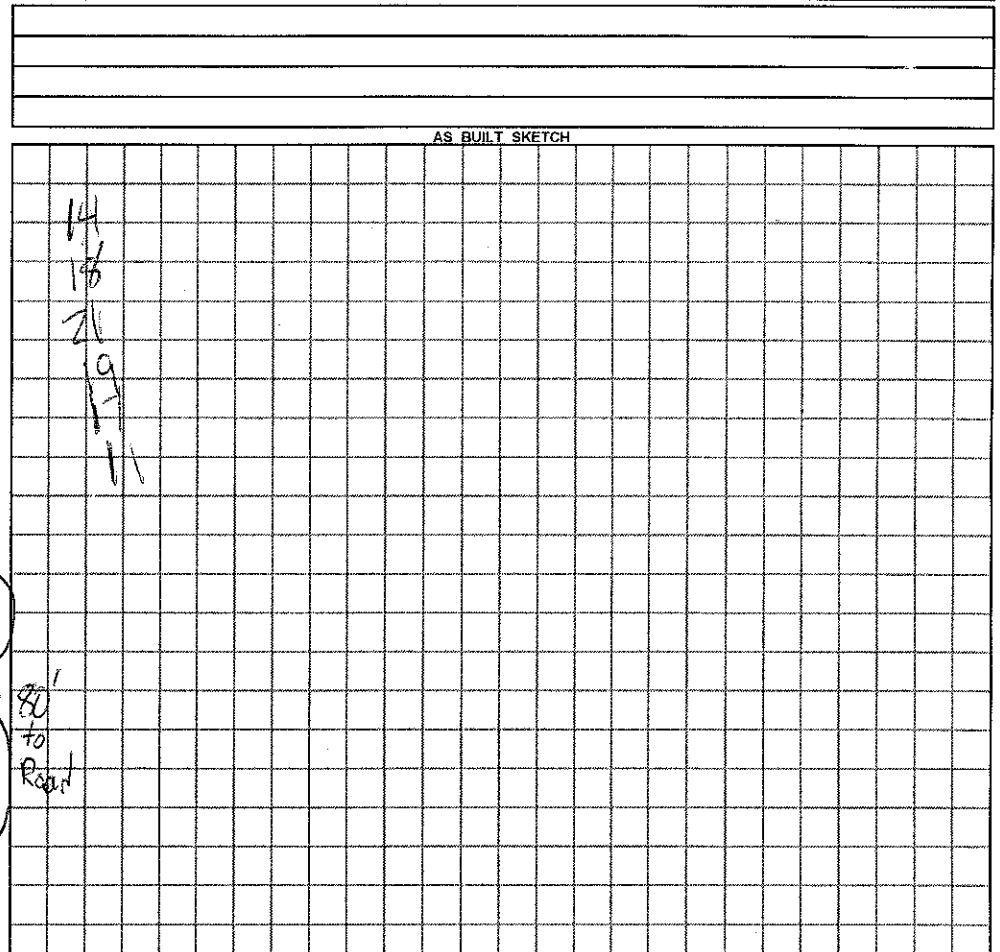

Permit can be suspended or revoked if any false information is supplied toward securing the permit / any unauthorized changes are made to the site / any unauthorized changes are made in the installation of the system.

☐ ***IMPROVEMENT PERMIT*** *with plat valid without expiration.* ☒ ***IMPROVEMENT PERMIT*** *with plat ~~valid without expiration~~ site plan valid 60 mo.* ☒ ***AUTHORIZATION TO CONSTRUCT*** valid for period equal to IMPROVEMENT PERMIT--not to exceed 60 mo.

Owner / Applicant Signature: Valerie Stevens Date 6-1-12 Installed by: Rowan Septic

IMPROVEMENT PERMIT by: James REHS Date 5-30-12 OPERATION PERMIT by: James REHS Date 10-23-12

AUTHORIZATION TO CONSTRUCT by: James REHS Date 5-30-12 Existing System Inspected by: REHS Date

YOU SHOULD CONTACT A LOCATOR SERVICE PRIOR TO ANY EXCAVATION

White Copy – Environmental Health YELLOW COPY (Final) Owner / Applicant PINK COPY (Initial) Owner / Applicant