IREDELL COUNTY HEALTH DEPARTMENT

STATESVILLE 704-878-5305 (ad) MOORESVILLE 704-664-5281

IMPROVEMENT PERMIT / AUTHORIZATION TO CONSTRUCT / OPERATION PERMIT / EXISTING SYSTEM INSPECTION

PERMIT # 14934 | PIN # 4715538975 | DATE 3-20-09

OWNER or APPLICANT C&D Excavating LLC | PHONE: Business | Home: 704-872-7855

OWNER or APPLICANT ADDRESS 118 Sara Beth Ln Statesville 28625

LOCATION / DIRECTIONS I-40 W to Woodbridge to Russell to Dempsey on left

SUBDIVISION Briarwood Woodbridge | BLOCK / SECTION | LOT # 31 | LOT AREA .67 | DESIGN FLOW 480 | L.T.A.R. .3

Septic Tank 1000 Gallons: STB 525 Date 5-26-09
Pump Tank Gallons: P T Date
Pump Make Model Serial #
Nitrification Field No Fields No Lines 4 Linear Feet 400
Trench Width 36" Max. Trench Bottom Depth 36" Gravel Depth NA

☑ New System ☐ Repair ☐ Expansion System Type I II III IV V VI
System Description: 25% Graud
Repair System Description: 50% Lin Feet
Maintenance Agreement Required ☐ YES ☑ NO
☑ GRAVITY ☐ PRESSURE


☑ Residence No. Bedrooms 3+4 (1+4)
☐ Business No. Persons
☐ Other No. Employees
☐ Slab ☐ Crawl Space
☐ Basement w/plumbing ☐ Basement w/o plumbing

Water Supply: ☐ Private ☑ Public ☐ Community


Comments / Conditions

Comments / Conditions
Upstall on bottom
Maintain all setback
36" Trench Bottom

INITIAL SITE SKETCH

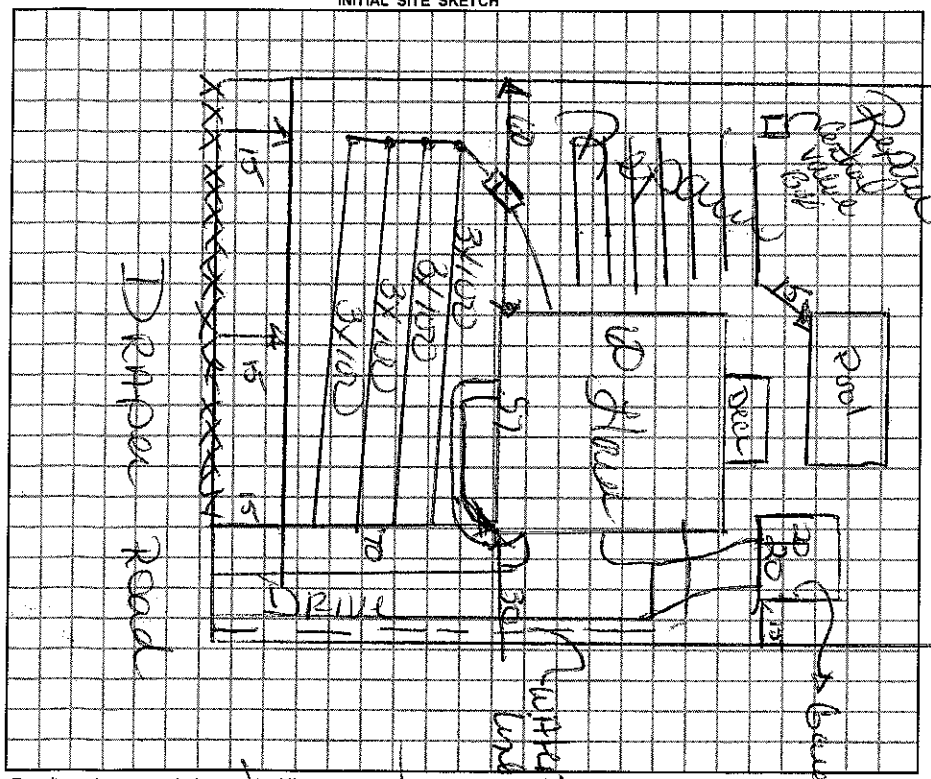

AS BUILT SKETCH

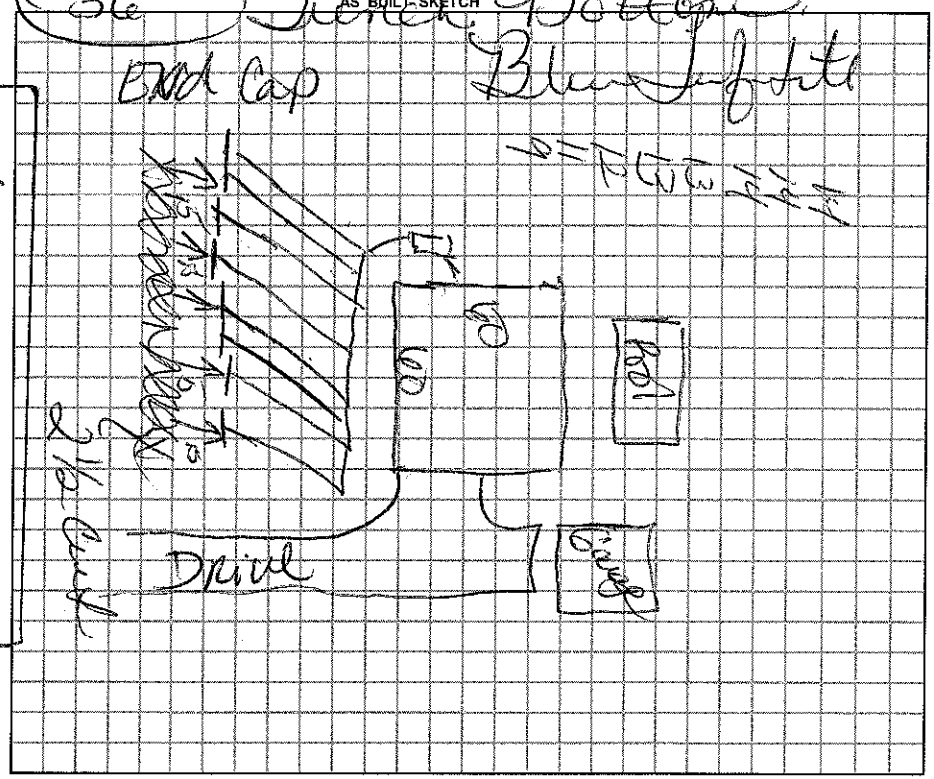

Permit can be suspended or revoked if any false information is supplied toward securing the permit / any unauthorized changes are made to the site / any unauthorized changes are made in the installation of the system.

☐ *IMPROVEMENT PERMIT w / plat valid without expiration.* ☑ *IMPROVEMENT PERMIT w / site plan valid for 60 mos.* ☑ *AUTHORIZATION TO CONSTRUCT valid for period equal to IMPROVEMENT PERMIT-not to exceed 60 mo.*

Owner / Applicant Signature: Date 4/6/09
Improvement Permit by: Date 3-23-09
Authorization to Construct by: R.S. Date 16 Apr 09

Installed by: Rowan Septic
Operation Permit by: Date: 7-28-09
Existing System Inspected by: Date:

YOU SHOULD CONTACT A LOCATOR SERVICE PRIOR TO ANY EXCAVATION.

WHITE COPY Environmental Health YELLOW COPY (Final) Owner / Applicant PINK COPY (Initial) Owner / Applicant