Replaces Permit issued 5-6-08

**IREDELL COUNTY HEALTH DEPARTMENT - *ENVIRONMENTAL HEALTH*** ☐ STATESVILLE OFFICE 704-878-5305 ☐ MOORESVILLE OFFICE 704-664-5281

**IMPROVEMENT PERMIT / AUTHORIZATION TO CONSTRUCT @/ OPERATION PERMIT @/ EXISTING SYSTEM INSPECTION**

PERMIT # Relayout/149342 PIN # 4715-54-8170 DATE 7 July 2011

OWNER PMA INVESTMENTS APPLICANT: PHONE: Home/Cell # (704) 658-5514 Business #

SITE ADDRESS 123 Drapers Bend St. OWNER / APPLICANT ADDRESS


SITE DIRECTIONS 64/90 - Turn onto Woodbridge Trail Russell Rd - TR Drapers Br. on left.

SUBDIVISION Woodbridge BLOCK / SECTION 2 LOT # 32 LOT AREA 0.67ac. DESIGN FLOW 480g/d L.T.A.R. 0.3g/ft²


| | | | | | | | | | |
|---|---|---|---|---|---|---|---|---|---|
| Septic Tank 1000 | Gallons: STB 825 | Date 11-28-11 | ☑ New System | ☐ Repair | ☐ Expansion System | Type I II (III) IV V VI | ☑ Residence | No. Bedrooms 4 | Water Supply |
| Pump Tank | Gallons: P T | Date | System Description: 25% Reduction | | | | ☐ Business | No. Persons | ☐ Private |
| Pump Make | Model | Serial # | Repair System Description: 50% Reduction LPP distribution | | | | ☐ Other | No. Employees | ☑ Public |
| No. Nitrification Fields: 1 | No. Lines 8 | Linear Feet 400 | Maintenance Agreement Required | ☐ YES | ☑ NO | | ☐ Slab | ☑ Crawl Space | ☐ Community |
| Trench Width 36" | Max. Trench Bottom Depth 36" | | Gravel Depth NA | ☑ GRAVITY | ☐ PRESSURE | | ☐ Basement w/plumbing | ☐ Basement w/o plumbing | |

Comments / Conditions Fullum contour / Homer Setbacks

INITIAL SITE SKETCH

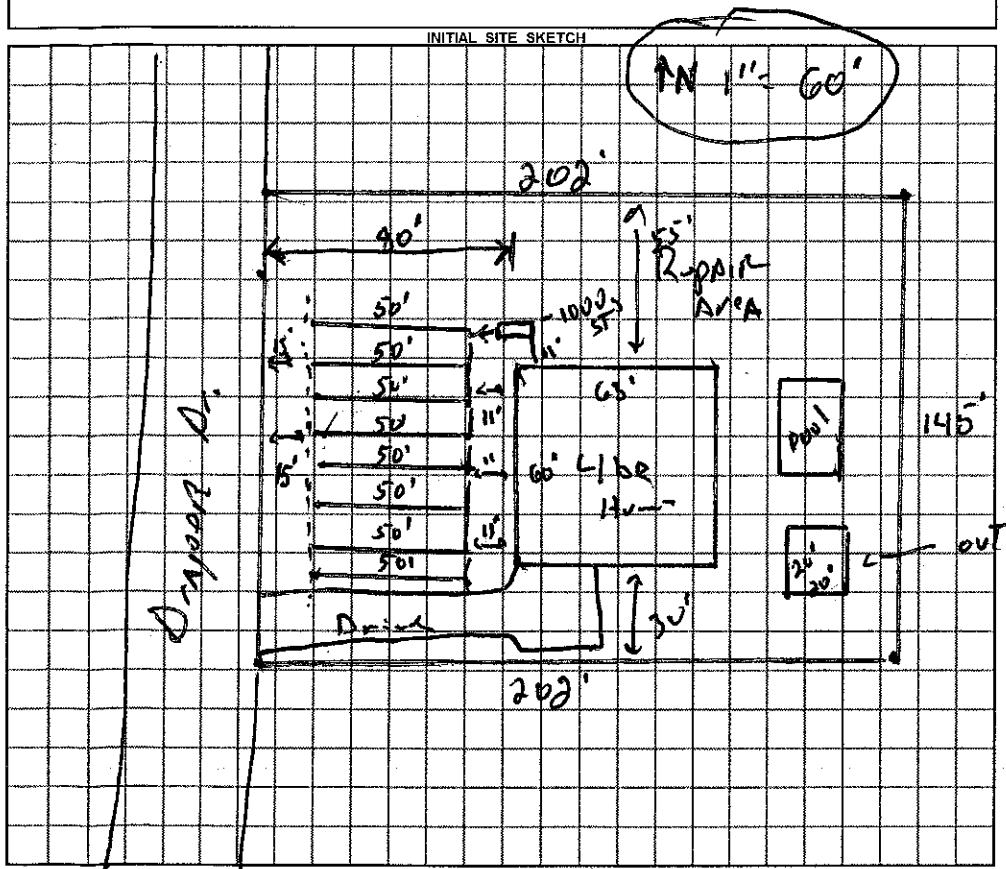


AS BUILT SKETCH

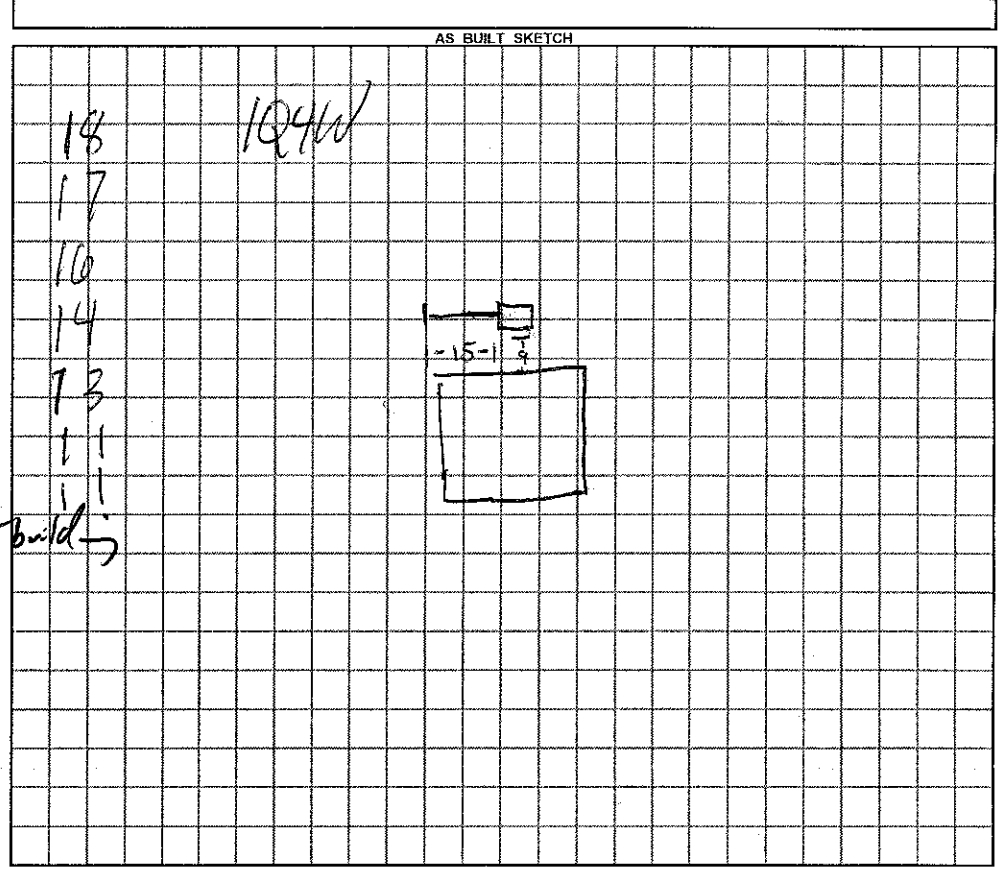


*Permit can be suspended or revoked if any false information is supplied toward securing the permit / any unauthorized changes are made to the site / any unauthorized changes are made in the installation of the system.*

☐ *IMPROVEMENT PERMIT with plat valid without expiration.* ☑ *IMPROVEMENT PERMIT with plat valid without expiration. site plan valid 60 mo.* ☑ *AUTHORIZATION TO CONSTRUCT* valid for period equal to IMPROVEMENT PERMIT--not to exceed 60 mo.

Owner / Applicant Signature: Valerie Stevens Date 7-11-11 Installed by: Rowan Septic

IMPROVEMENT PERMIT by: REHS Date 7 July 11 OPERATION PERMIT by: REHS Date 1-25-12

AUTHORIZATION TO CONSTRUCT by: REHS Date 7 July 11 Existing System Inspected by: REHS Date

***YOU SHOULD CONTACT A LOCATOR SERVICE PRIOR TO ANY EXCAVATION***

White Copy – Environmental Health YELLOW COPY (Final) Owner / Applicant PINK COPY (Initial) Owner / Applicant