IREDELL COUNTY HEALTH DEPARTMENT - *ENVIRONMENTAL HEALTH* ☐ STATESVILLE OFFICE 704-878-5305 (CN) ☐ MOORESVILLE OFFICE 704-664-5281 RC

IMPROVEMENT PERMIT / AUTHORIZATION TO CONSTRUCT (2) / OPERATION PERMIT / EXISTING SYSTEM INSPECTION

PERMIT # 163584 PIN # 4715-54-8277 DATE 10-26-10

OWNER PMA Investments, LLC APPLICANT: PHONE: Home/Cell # (704) 622-1881 Business # (704) 658-5514

SITE ADDRESS 115 Draper Dr. Statesville, NC OWNER / APPLICANT ADDRESS P.O. Box 5475 Statesville, NC

SITE DIRECTIONS Hwy 64W TL Woodbridge TL Russell Ridge TR Draper Dr. on Left.

SUBDIVISION Woodbridge Estates BLOCK / SECTION 2 LOT # 33 LOT AREA 0.687ac. DESIGN FLOW 480 gpd L.T.A.R. 0.3 gpd/ft²

Septic Tank	1000g	Gallons: STB	825	Date	1-3-11	☑ New System	☐ Repair	☐ Expansion System	Type I II (III) IV V VI
Pump Tank		Gallons: P T		Date		System Description:	25% Reduction		
Pump Make		Model		Serial #		Repair System Description:	50% Reduction LPP distribution		
No. Nitrification Fields:	1	No. Lines	8	Linear Feet	400	Maintenance Agreement Required	☐ YES	☑ NO	
Trench Width	36"	Max. Trench Bottom Depth	36"	Gravel Depth	NA	☑ GRAVITY	☐ PRESSURE		


☑ Residence No. Bedrooms 4 ☐ Business No. Persons ☐ Other No. Employees ☐ Slab ☑ Crawl Space ☐ Basement w/plumbing ☐ Basement w/o plumbing

Water Supply: ☐ Private ☑ Public ☐ Community


Comments / Conditions

SEPTIC TANK WITH RISERS INSTALLED USING POLY-LOK FILTER. 25% REDUCTION DRAINFIELD INSTALLED USING 100 QUICK-4 INFILTRATOR CHAMBERS AS SHOWN BELOW.

INITIAL SITE SKETCH

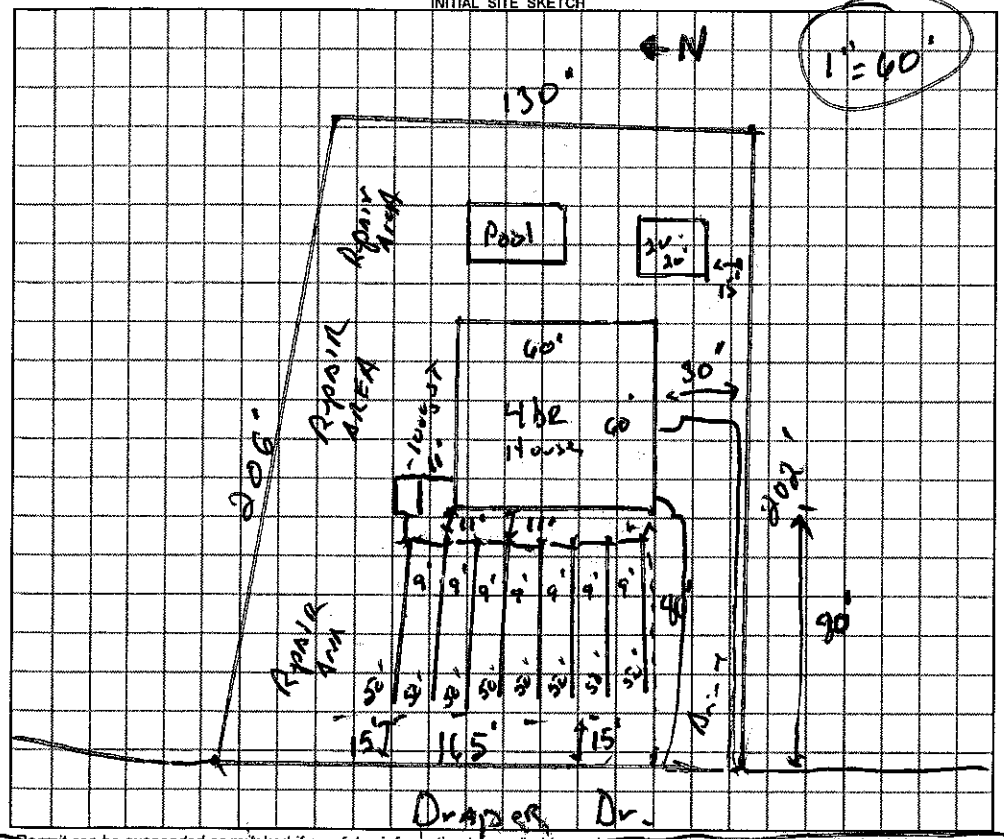

AS BUILT SKETCH

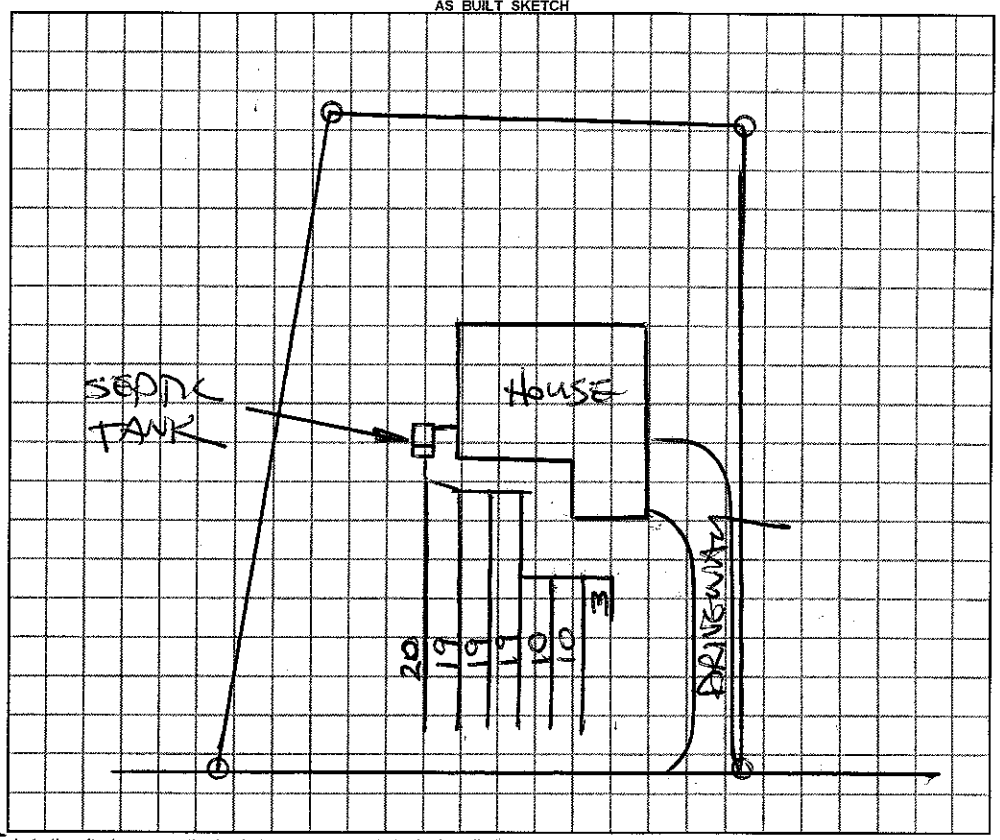

Permit can be suspended or revoked if any false information is supplied toward securing the permit / any unauthorized changes are made to the site / any unauthorized changes are made in the installation of the system.

☐ ***IMPROVEMENT PERMIT*** with plat valid without expiration. ☑ ***IMPROVEMENT PERMIT*** with plat valid without expiration. ☐ ***AUTHORIZATION TO CONSTRUCT*** valid for period equal to IMPROVEMENT PERMIT--not to exceed 60 mo.

Owner / Applicant Signature: [signature] Date 10/26/10 (expires 60 mo.) Installed by: Rowan Septic

IMPROVEMENT PERMIT by: [signature], R.S. REHS Date 26 Oct 10 OPERATION PERMIT by: Steve Hedrick REHS Date 4-19-11

AUTHORIZATION TO CONSTRUCT by: [signature], R.S. REHS Date 26 Oct. 10 Existing System Inspected by: REHS Date

YOU SHOULD CONTACT A LOCATOR SERVICE PRIOR TO ANY EXCAVATION

White Copy – Environmental Health YELLOW COPY (Final) Owner / Applicant PINK COPY (Initial) Owner / Applicant